

UNITED STATES
DEPARTMENT OF THE INTERIOR
BUREAU OF LAND MANAGEMENT


SECTION

Oregon State Water Filings

30

TOWNSHIP 23S., RANGE 30E., W. M. 02-1105

North

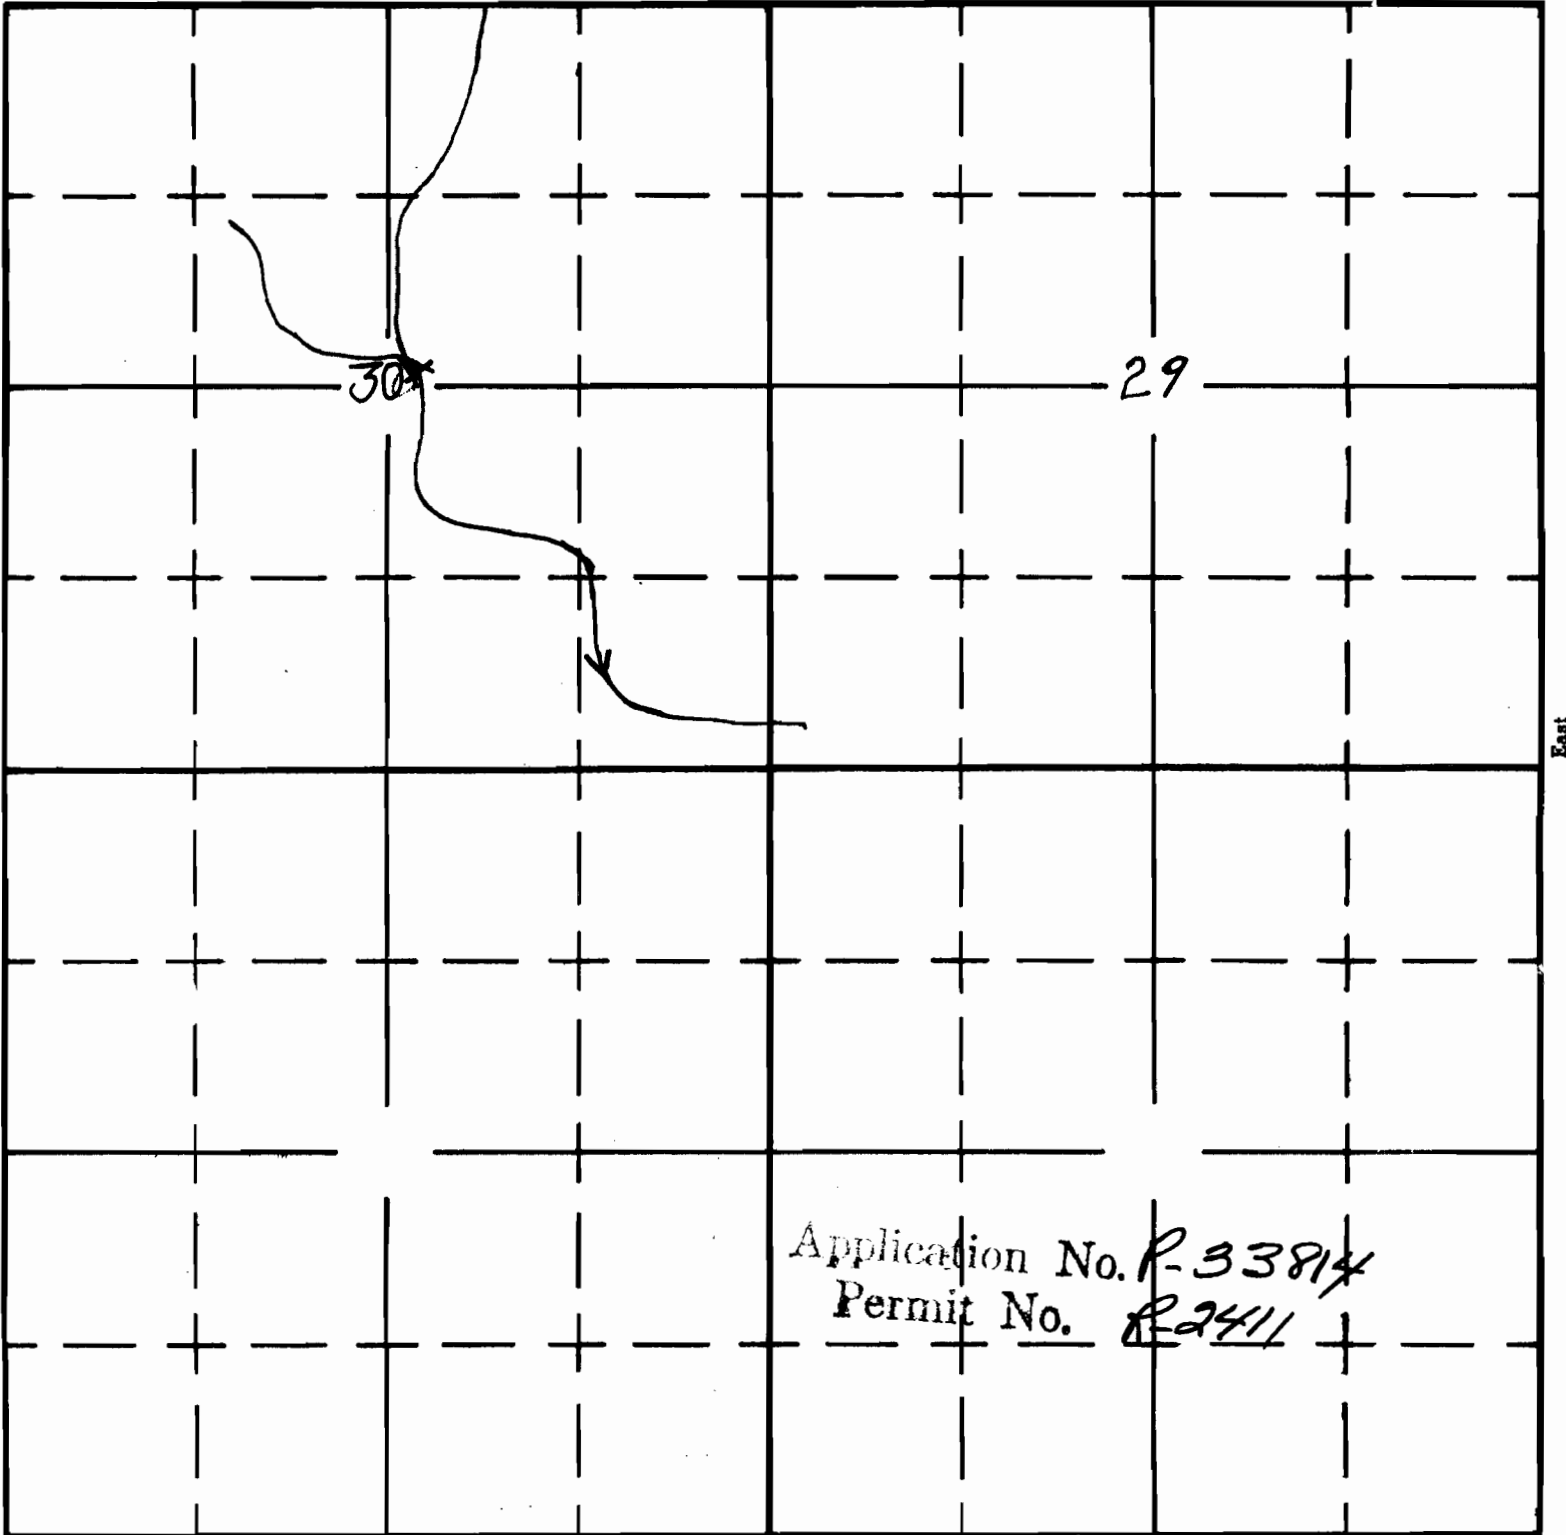

Application No. R-33814
Permit No. R-2411

Nearest found corner
SW corner section 6
T.24S. R.30E.

APPLICATION No.
PERMIT No.