

UNITED STATES
DEPARTMENT OF THE INTERIOR
BUREAU OF LAND MANAGEMENT


SECTION

Oregon State Water Filings

28

TOWNSHIP 29S, RANGE 29½E, W. M.

02-973

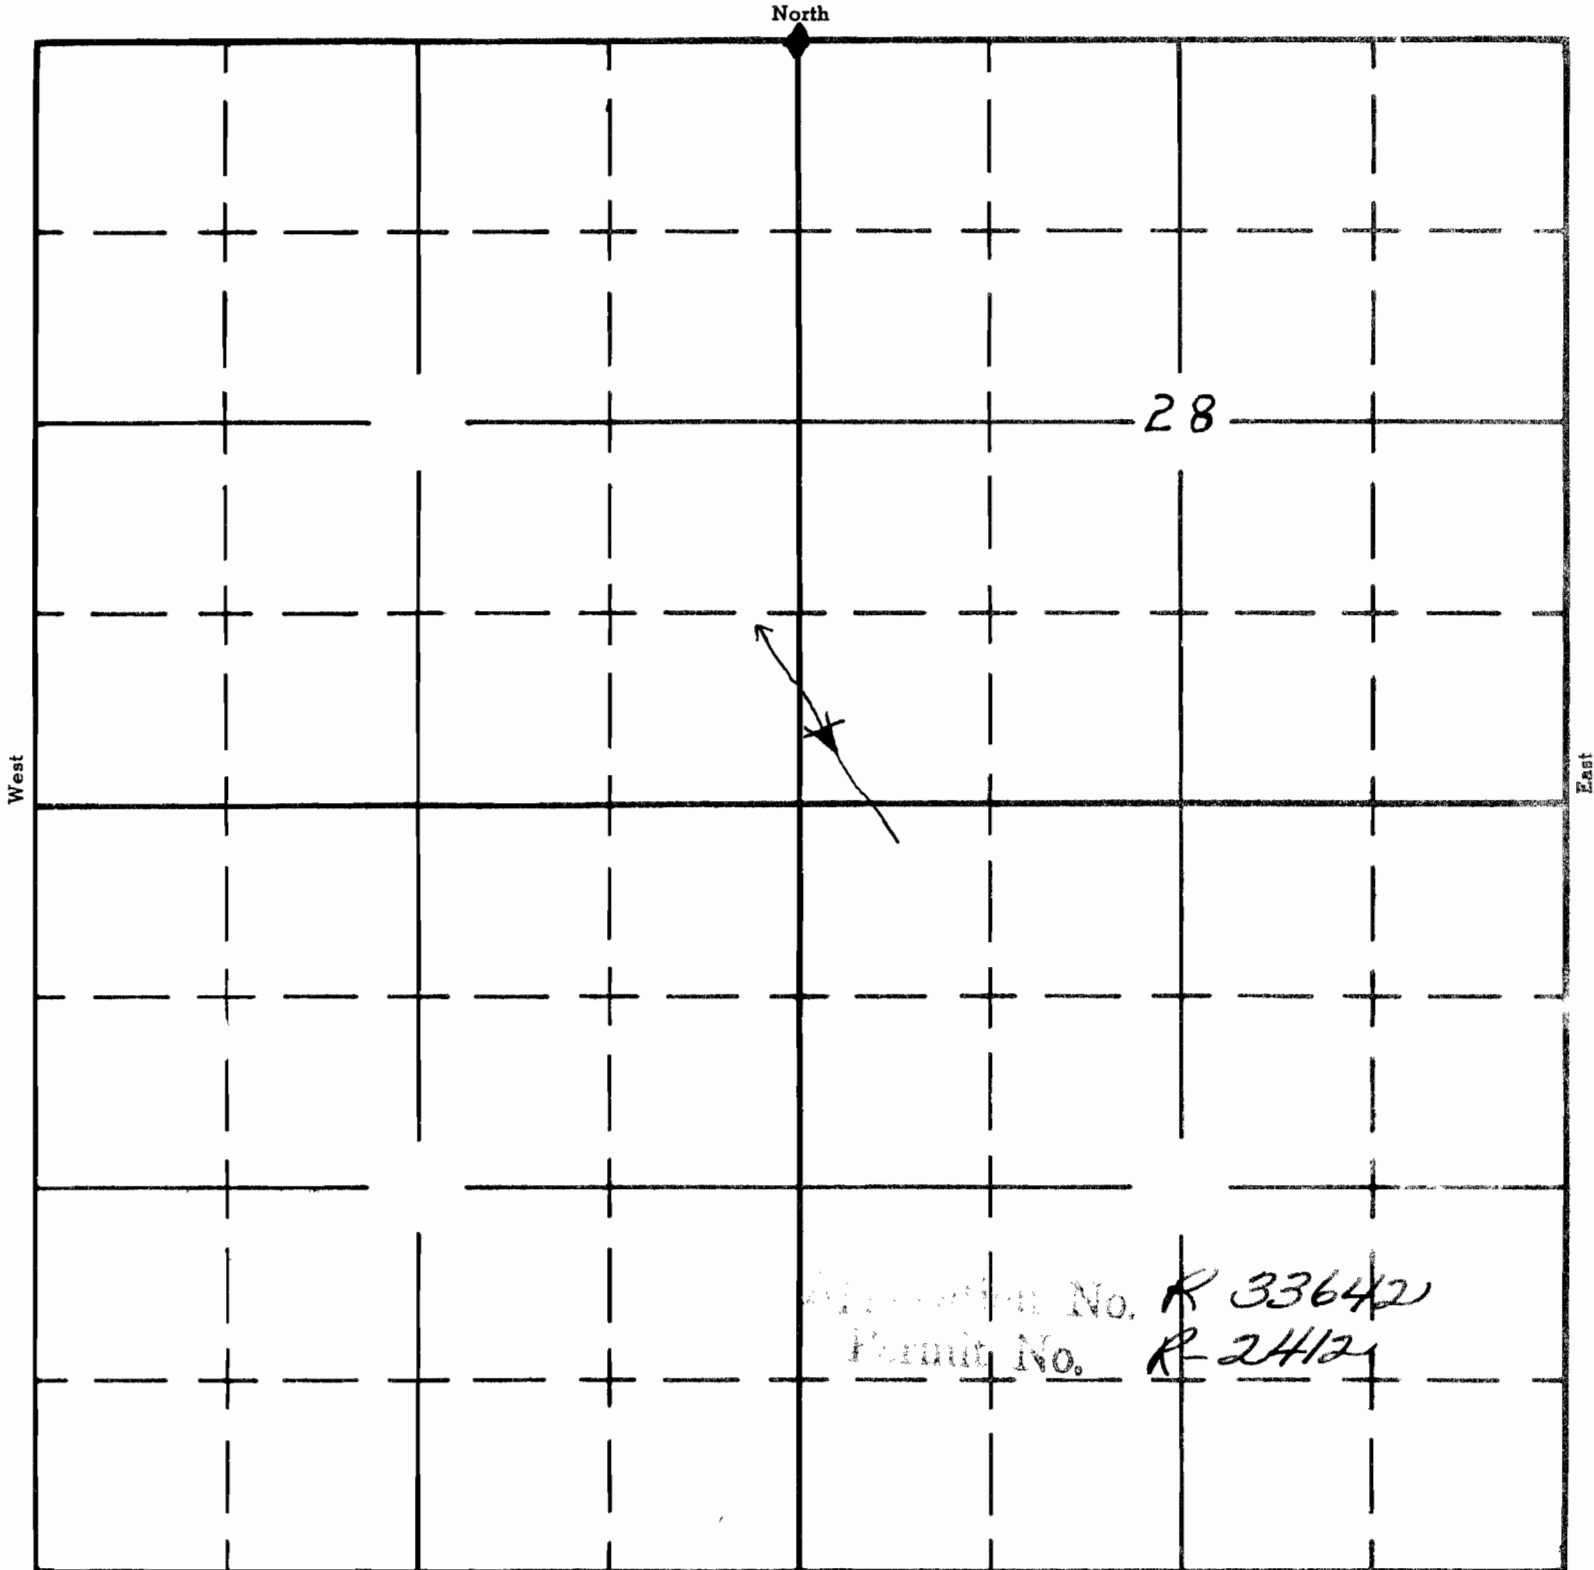

◆ Found corner

▲ Project location

South

APPLICATION No.

PERMIT No.