

UNITED STATES
DEPARTMENT OF THE INTERIOR
BUREAU OF LAND MANAGEMENT


SECTION

Oregon State Water Filings

33

TOWNSHIP 29S., RANGE 29½E., W. M. 02-976

North

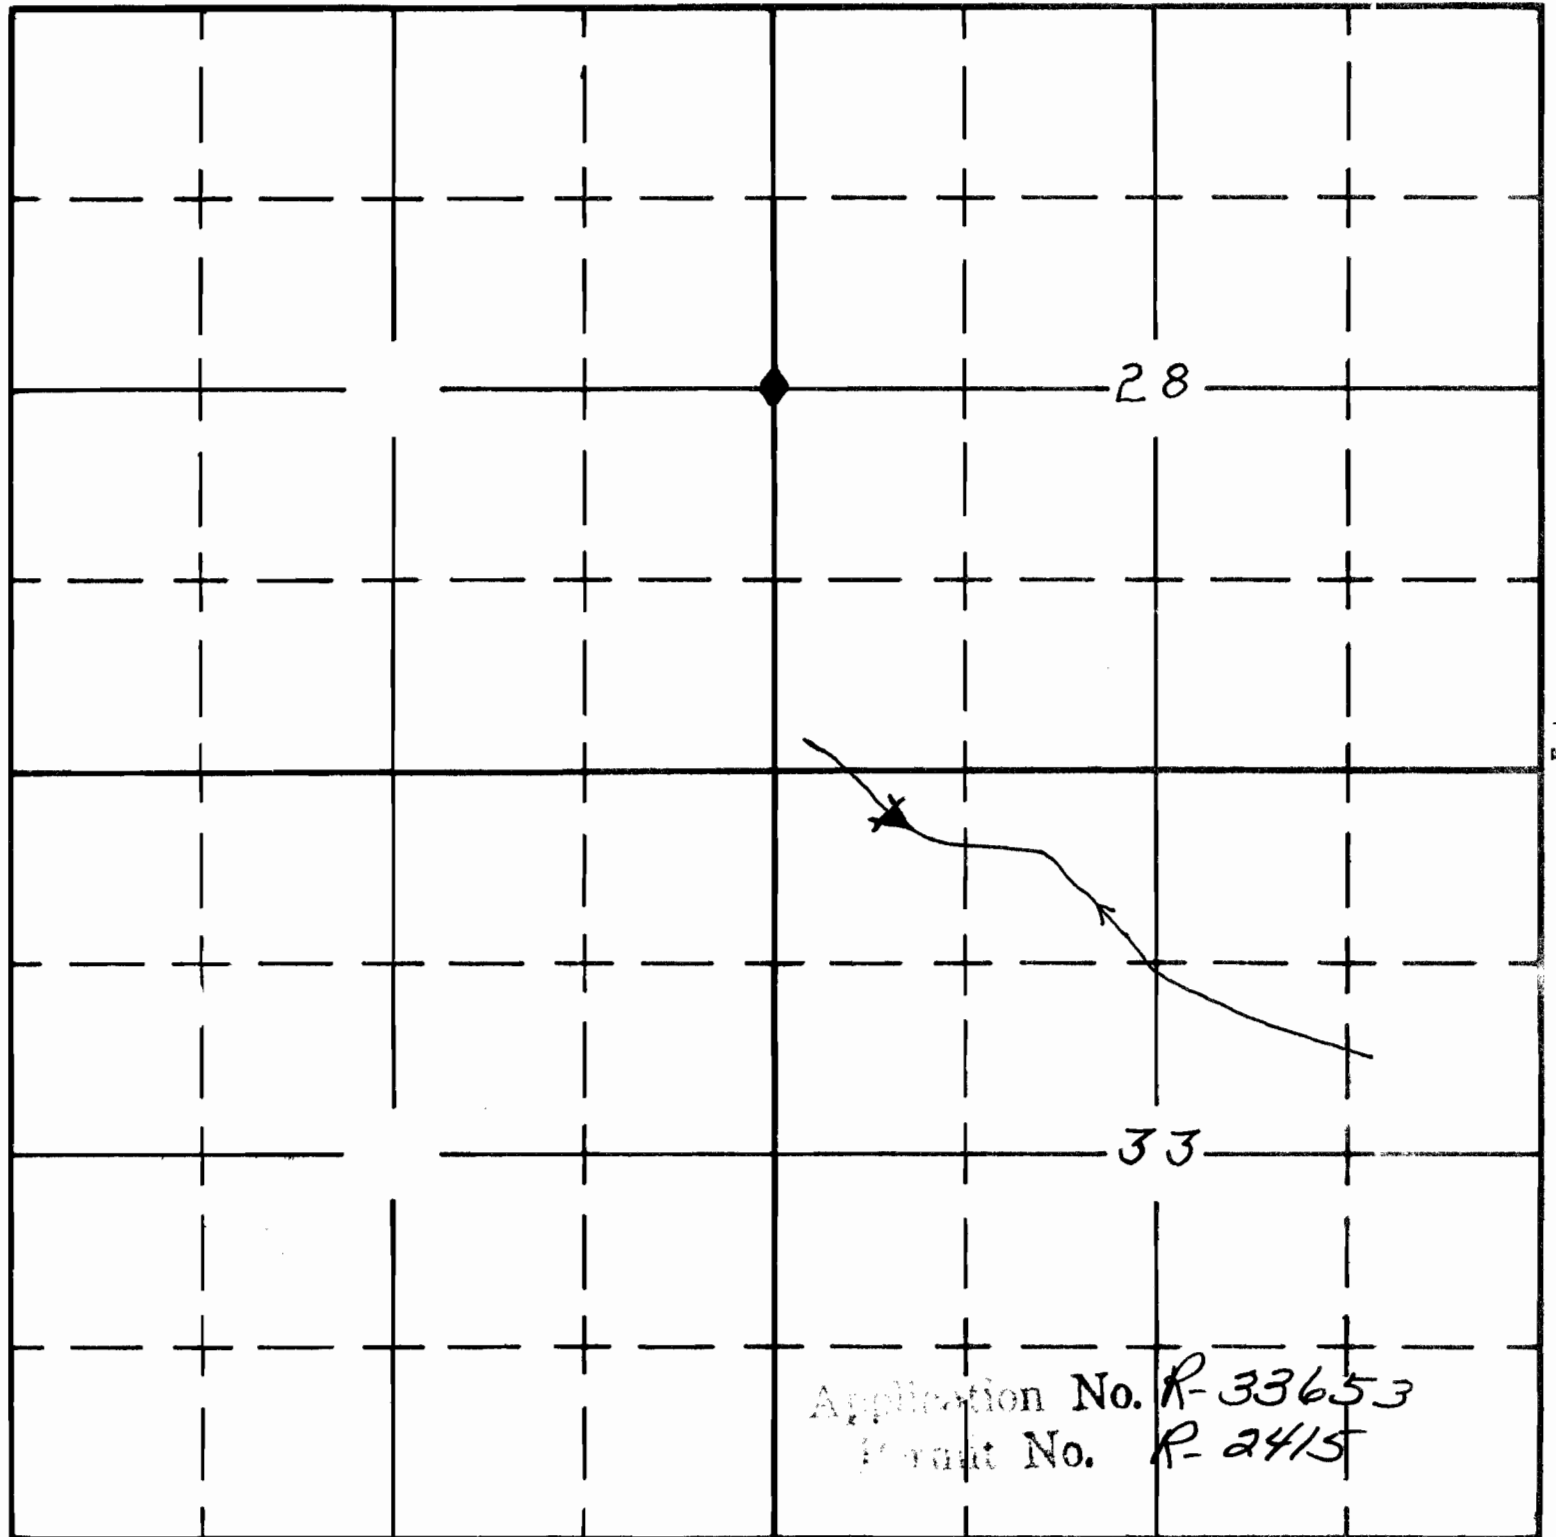

Nearest found corner
W ¼ corner section 28

South

APPLICATION No.
PERMIT No.