


UNITED STATES
DEPARTMENT OF THE INTERIOR
BUREAU OF LAND MANAGEMENT

SECTION _____
Oregon State Water Filings

25

TOWNSHIP 18 S., RANGE 26 E., W. M. T. S. - B-4

North

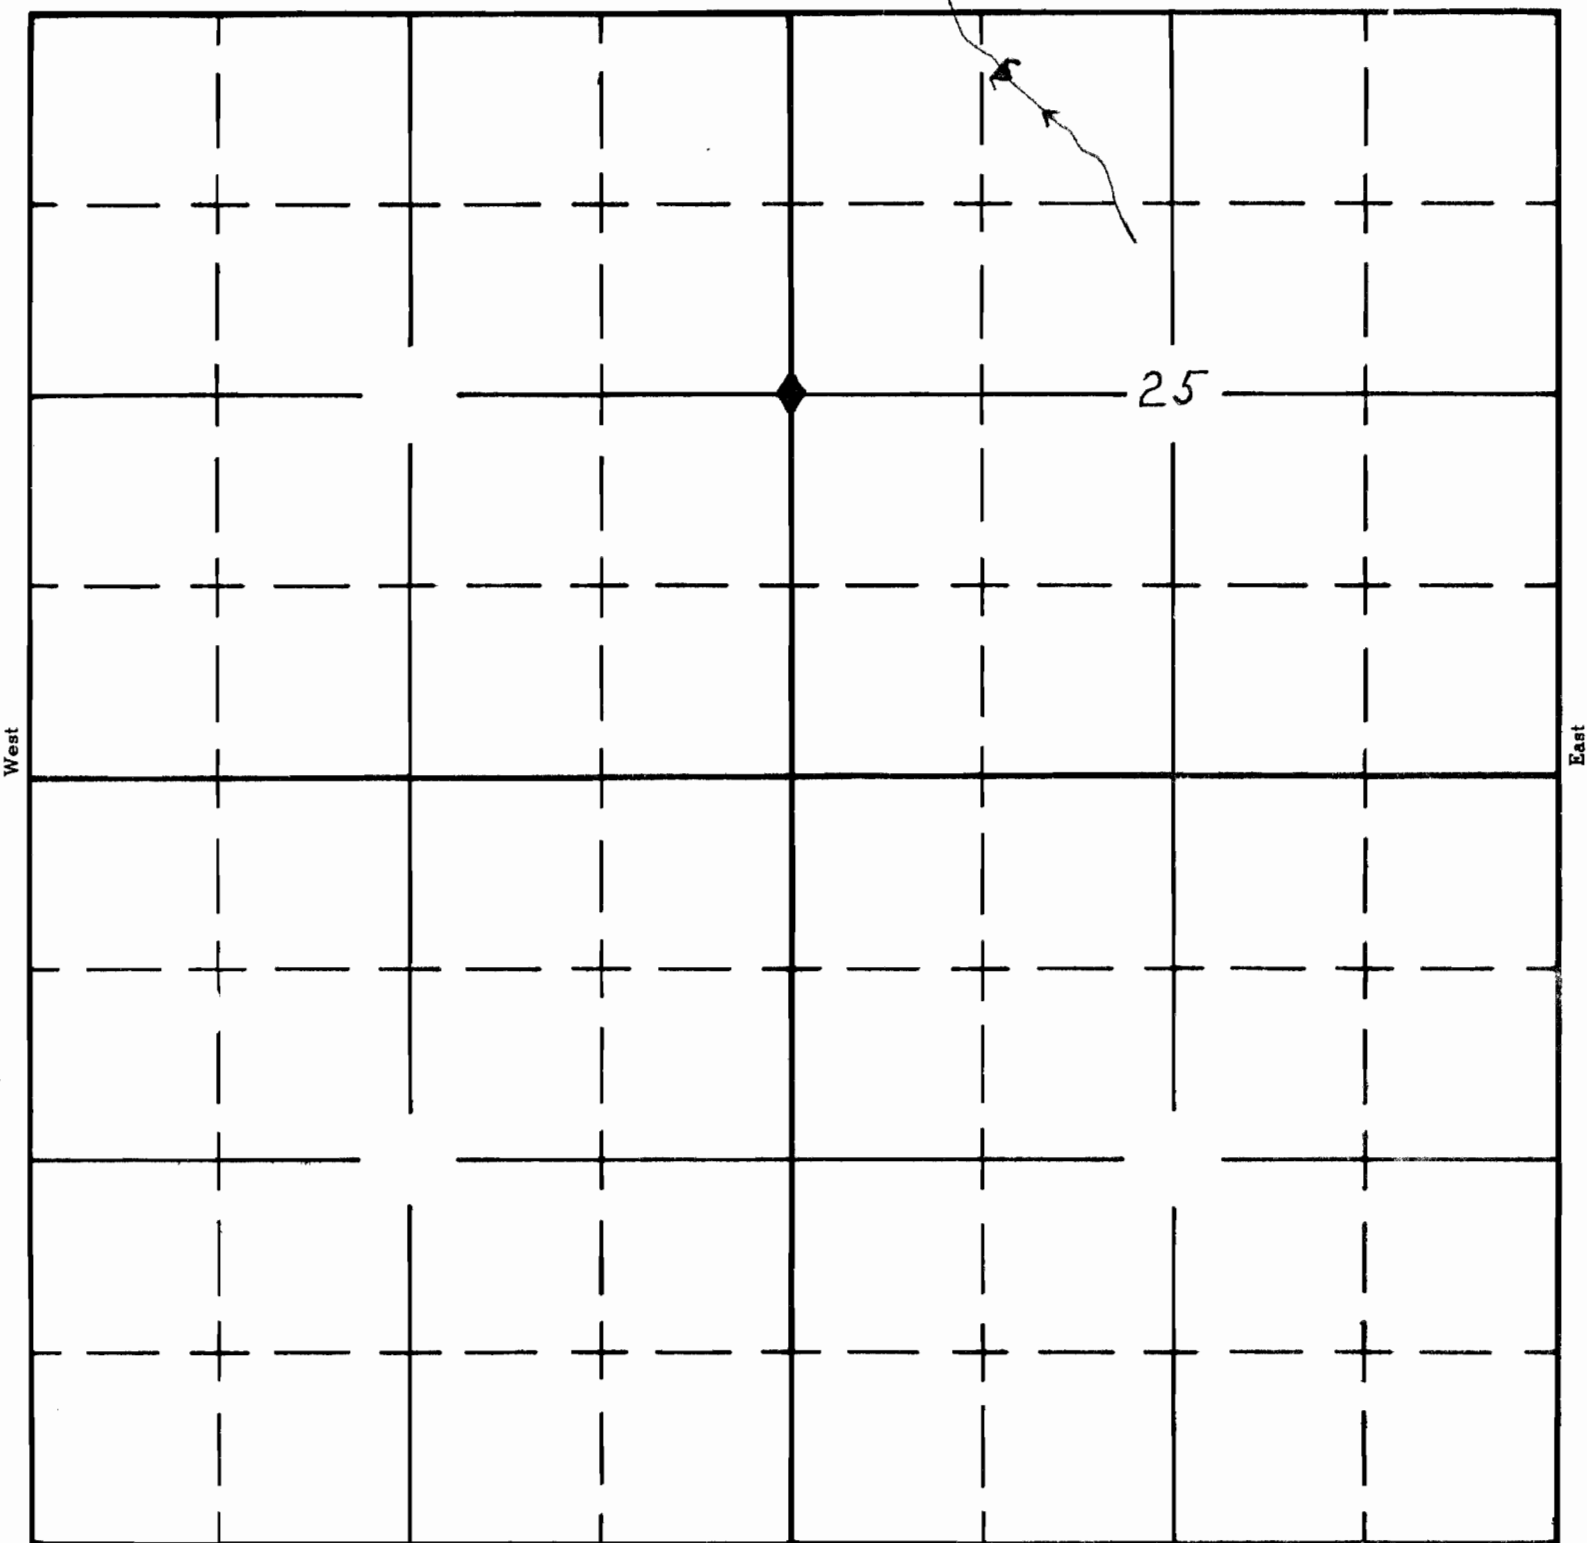

South

Application No. R-33644
Permit No. R-2473

APPLICATION No.
PERMIT No.