

UNITED STATES
DEPARTMENT OF THE INTERIOR
BUREAU OF LAND MANAGEMENT


SECTION

SW 1/4 SW 1/4
SEC. 11

Oregon State Water Filings

TOWNSHIP 21S., RANGE 30E., W. M.

North

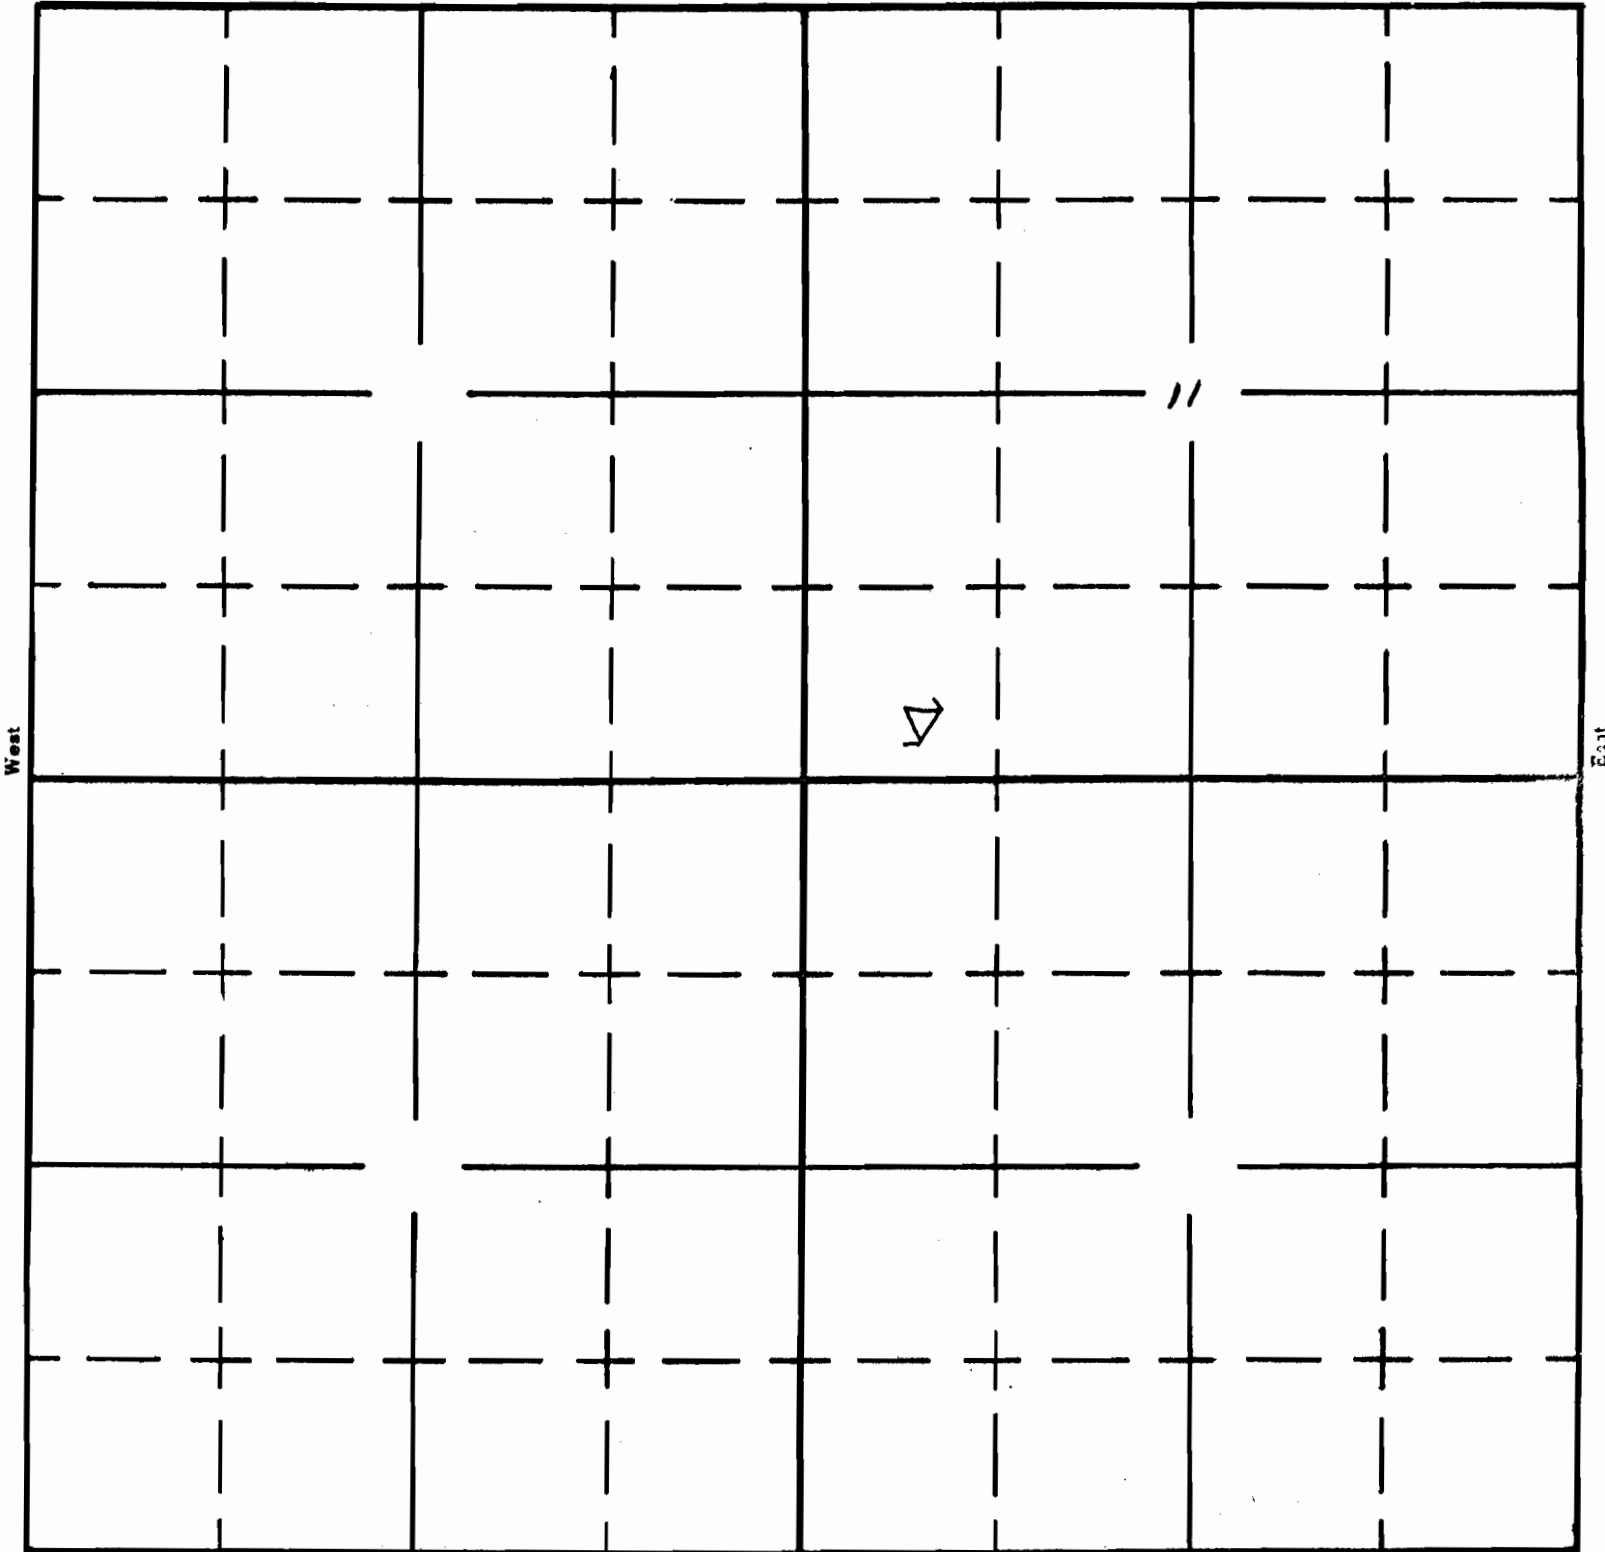

South

APPLICATION No. R-34914

PERMIT No. R-2770