

UNITED STATES
DEPARTMENT OF THE INTERIOR
BUREAU OF LAND MANAGEMENT

SECTION


6

NW 1/4 SW 1/4

Oregon State Water Filings

TOWNSHIP 22S, RANGE 3E, W. M.

North

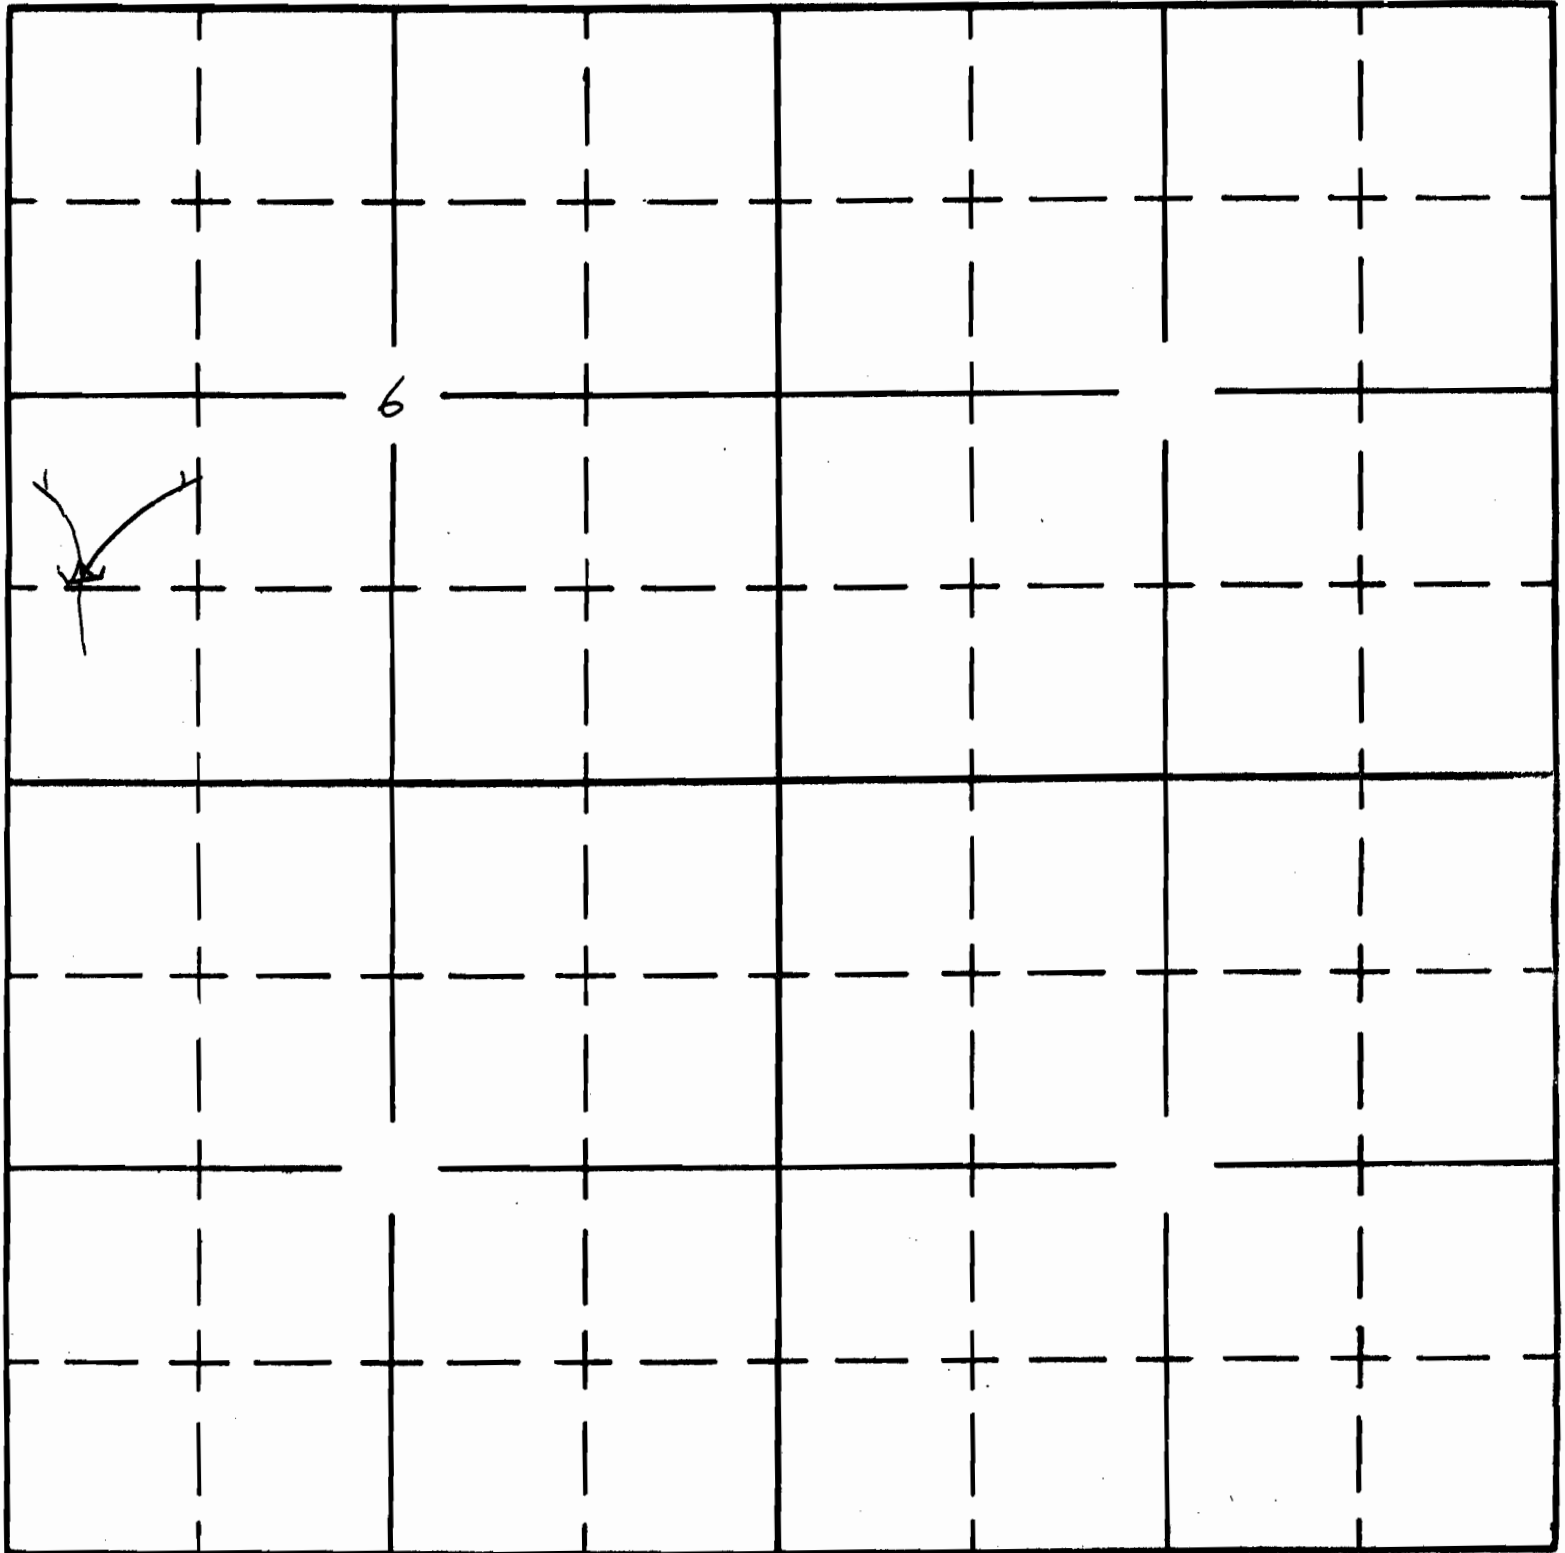

South

APPLICATION No. P-34918

PERMIT No. R-2774