

UNITED STATES
DEPARTMENT OF THE INTERIOR
BUREAU OF LAND MANAGEMENT

SECTION


9

SW 1/4 NW 1/4

Oregon State Water Filings

TOWNSHIP 2N5, RANGE 31E, W. M.

North

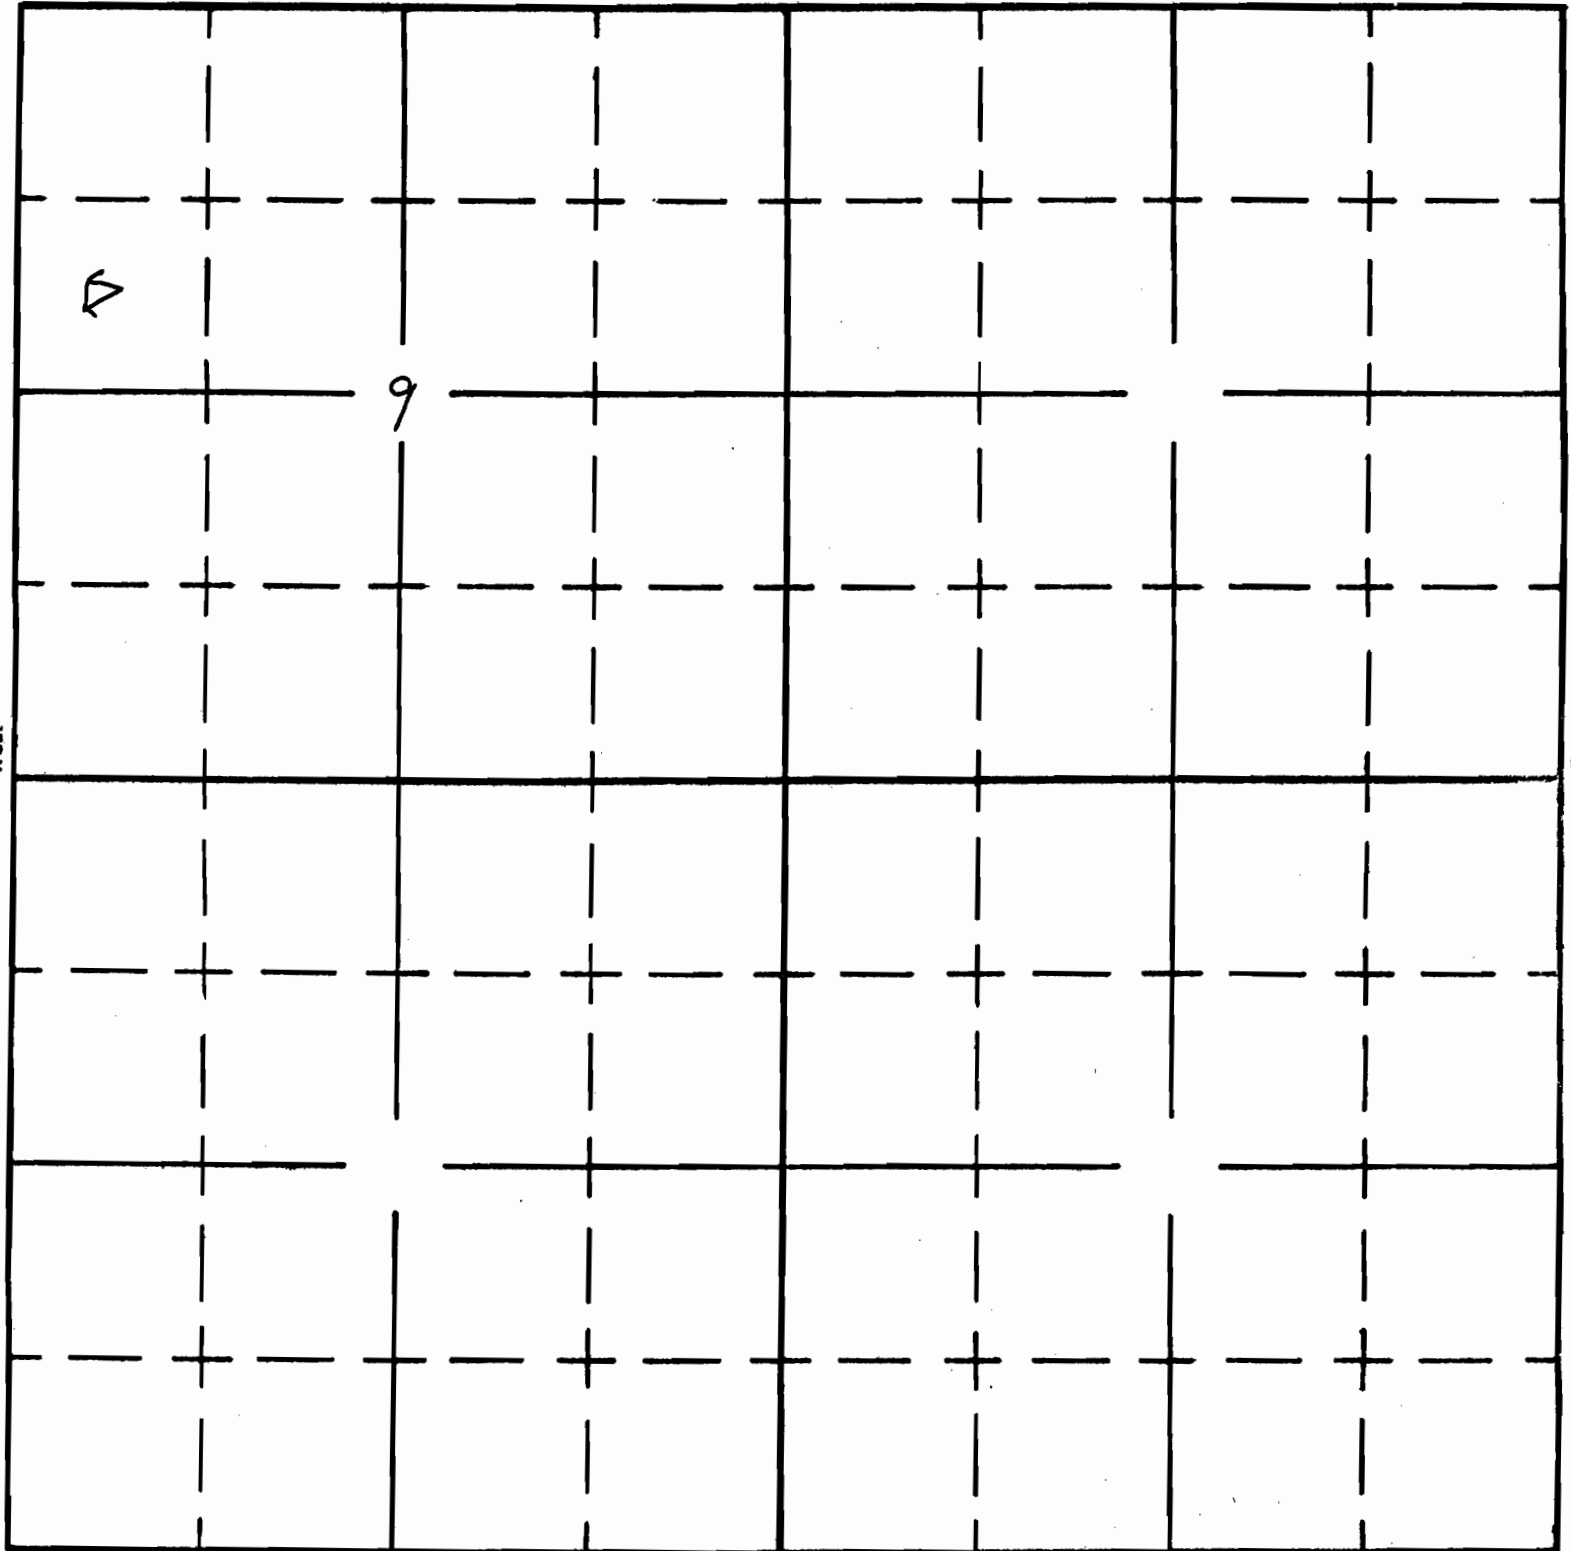

South

APPLICATION No. R-34920

PERMIT No. R-2776