

UNITED STATES
DEPARTMENT OF THE INTERIOR
BUREAU OF LAND MANAGEMENT


SECTION 3

SR 1/4 NE 1/4

Oregon State Water Filings

TOWNSHIP 24S, RANGE 34E, W. M.

North

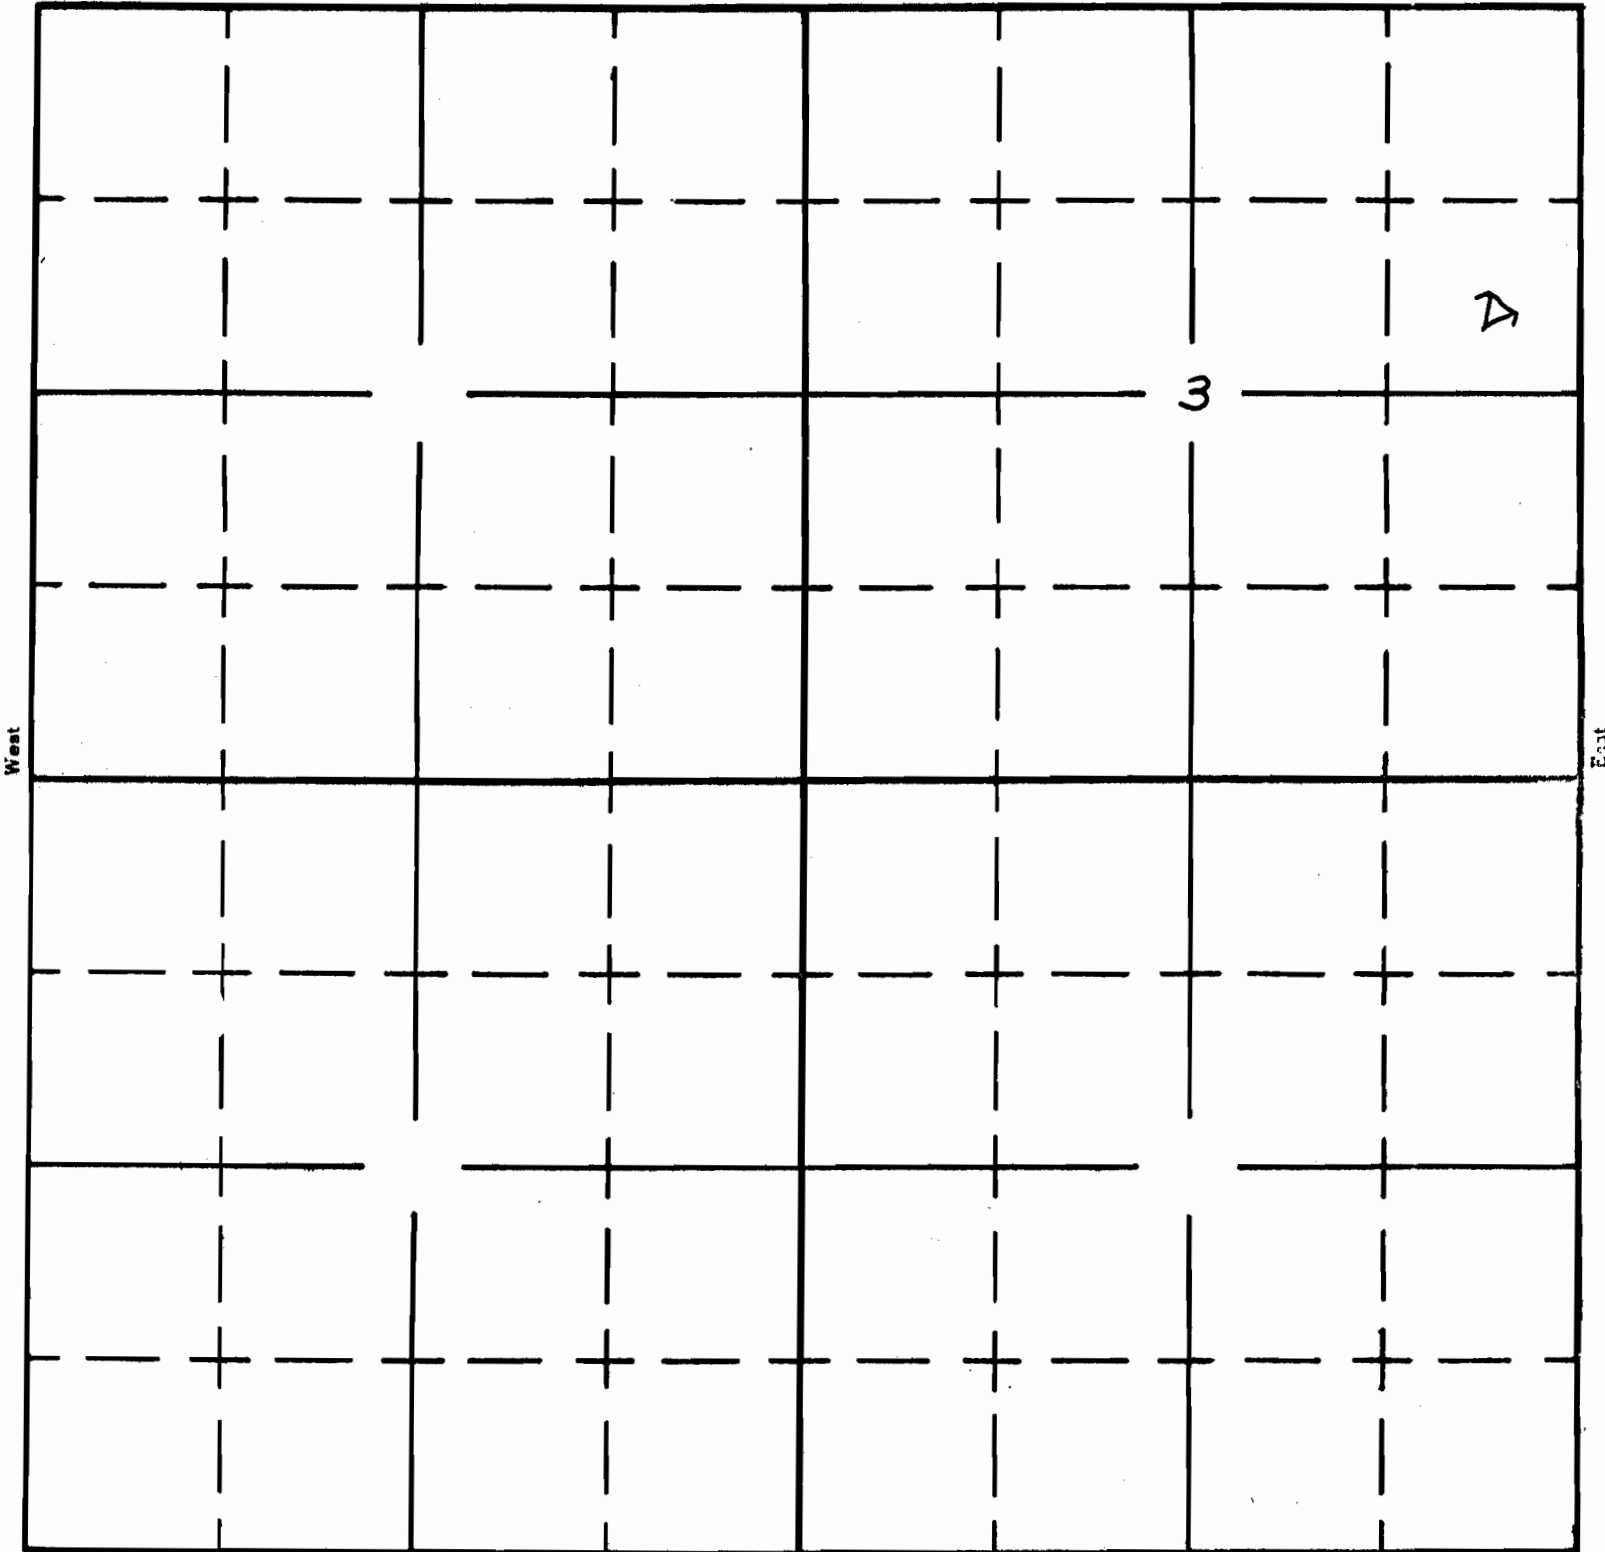

South

APPLICATION No. R-34922

PERMIT No. R-2778