

UNITED STATES
DEPARTMENT OF THE INTERIOR
BUREAU OF LAND MANAGEMENT

SECTION


34

SE 1/4 SW 1/4

Oregon State Water Filings

TOWNSHIP 28S, RANGE 34E, W. M.

North

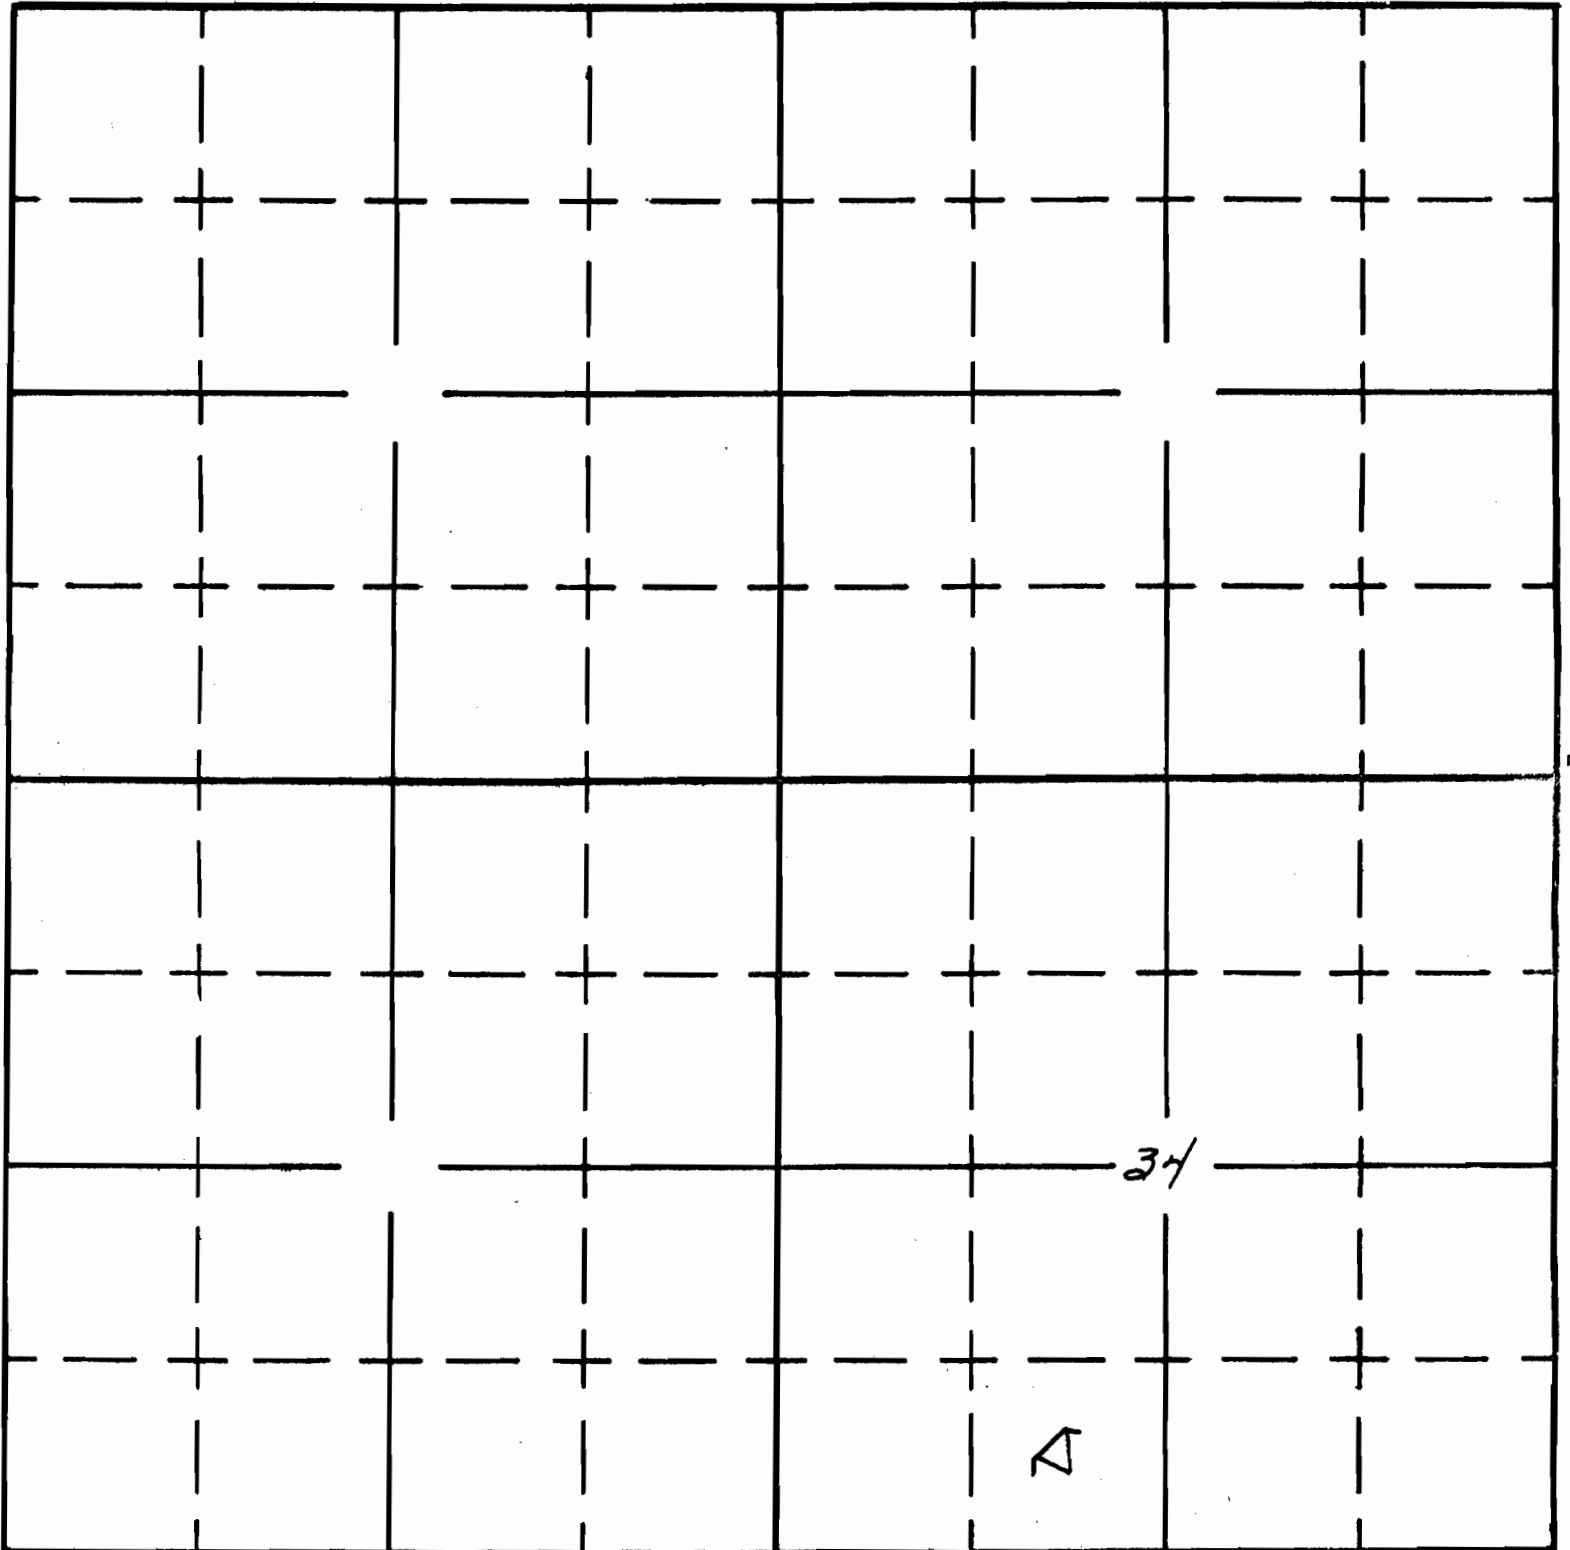

South

APPLICATION No. R-34923

PERMIT No. R-2779