

UNITED STATES
DEPARTMENT OF THE INTERIOR
BUREAU OF LAND MANAGEMENT

SECTION


NW 1/4 SW 1/4

SEC 4

Oregon State Water Filings

TOWNSHIP 24S, RANGE 34E, W. M.

North

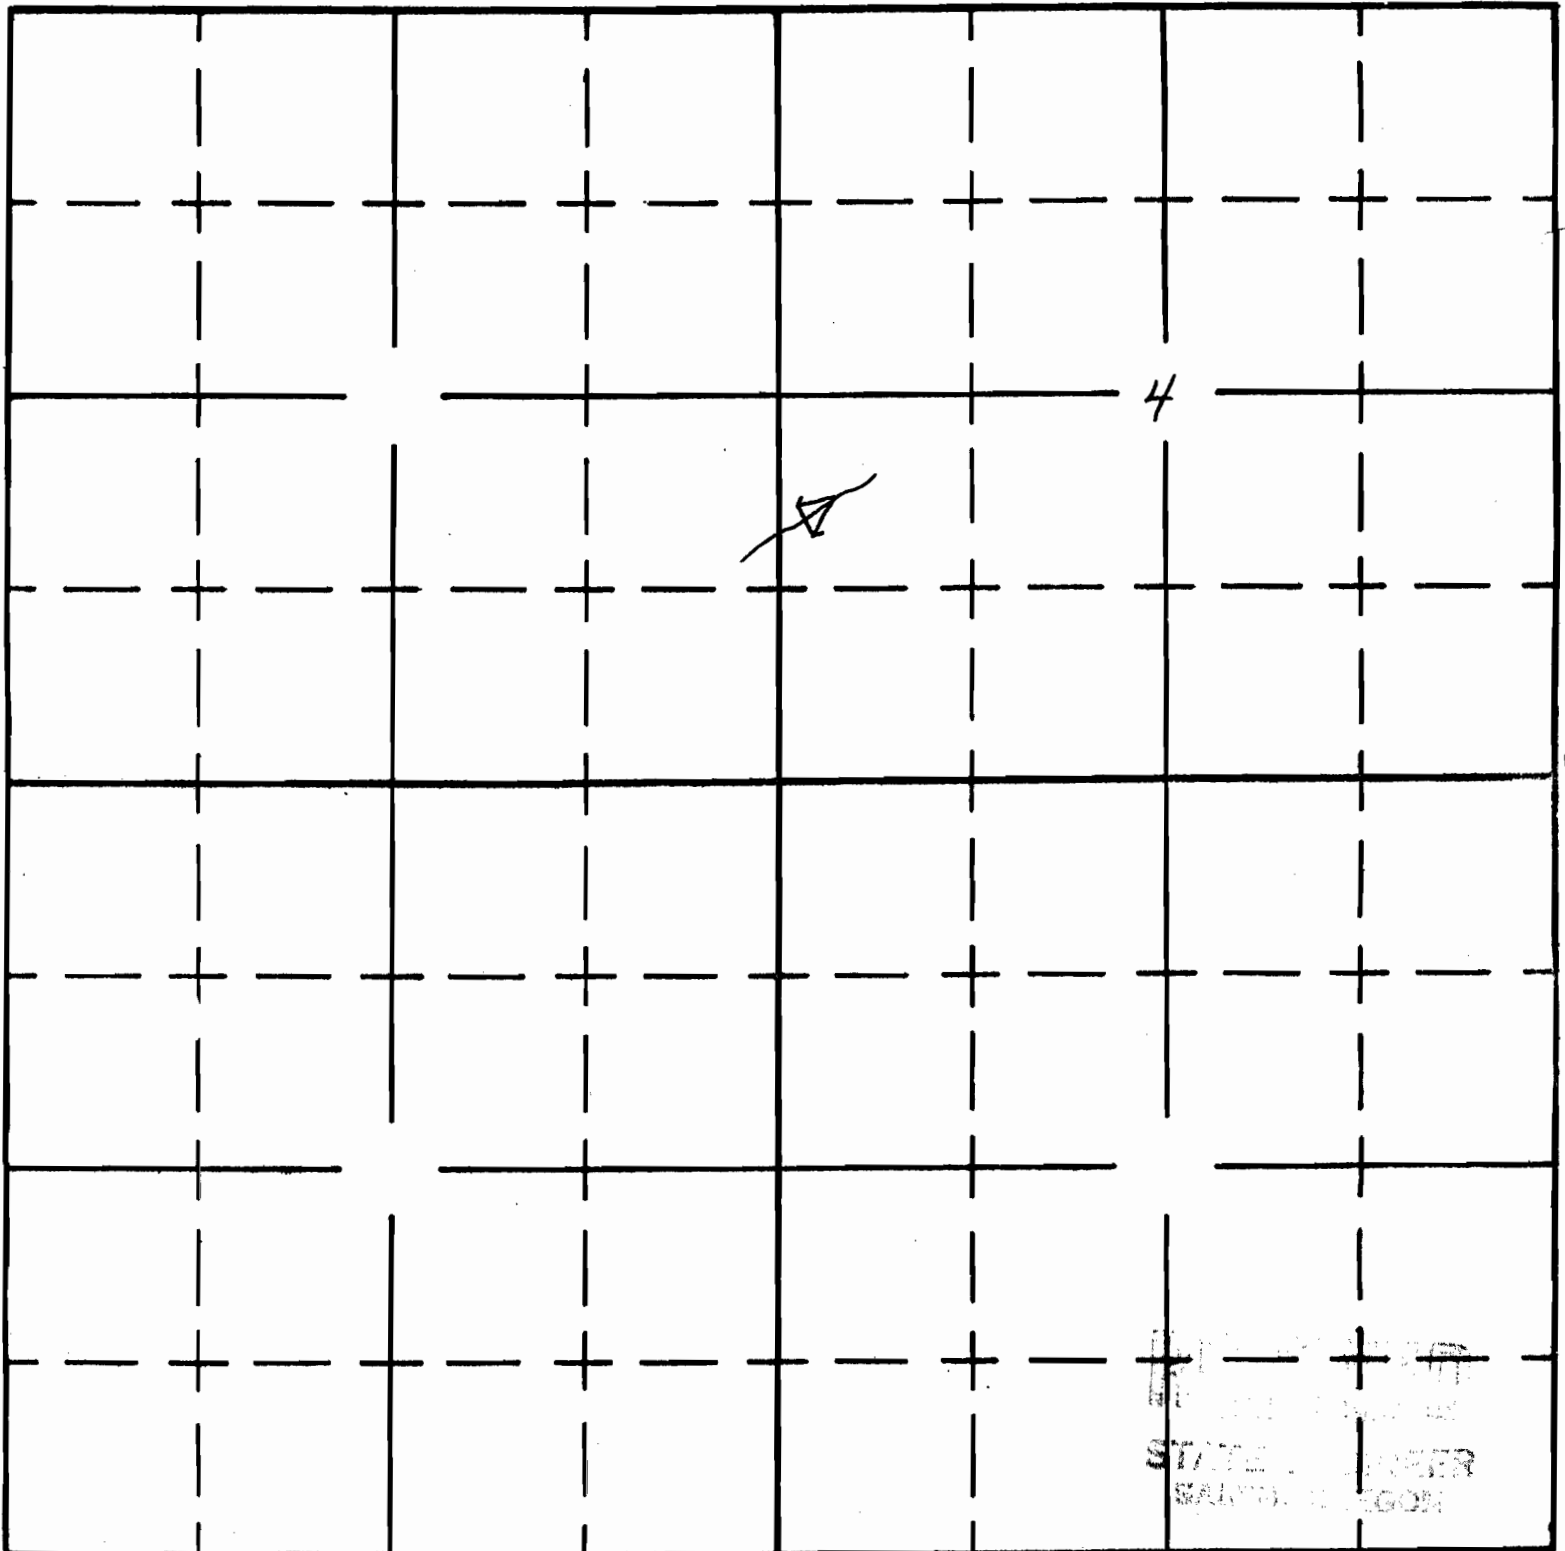

South

STATE ENGINEER

APPLICATION No. R-34924

PERMIT No. R-2780