


UNITED STATES
DEPARTMENT OF THE INTERIOR
BUREAU OF LAND MANAGEMENT

SECTION
NE $\frac{1}{4}$ SE $\frac{1}{4}$
Sec. 17

Oregon State Water Filings

TOWNSHIP 22 S, RANGE 3 E, W. M.

North

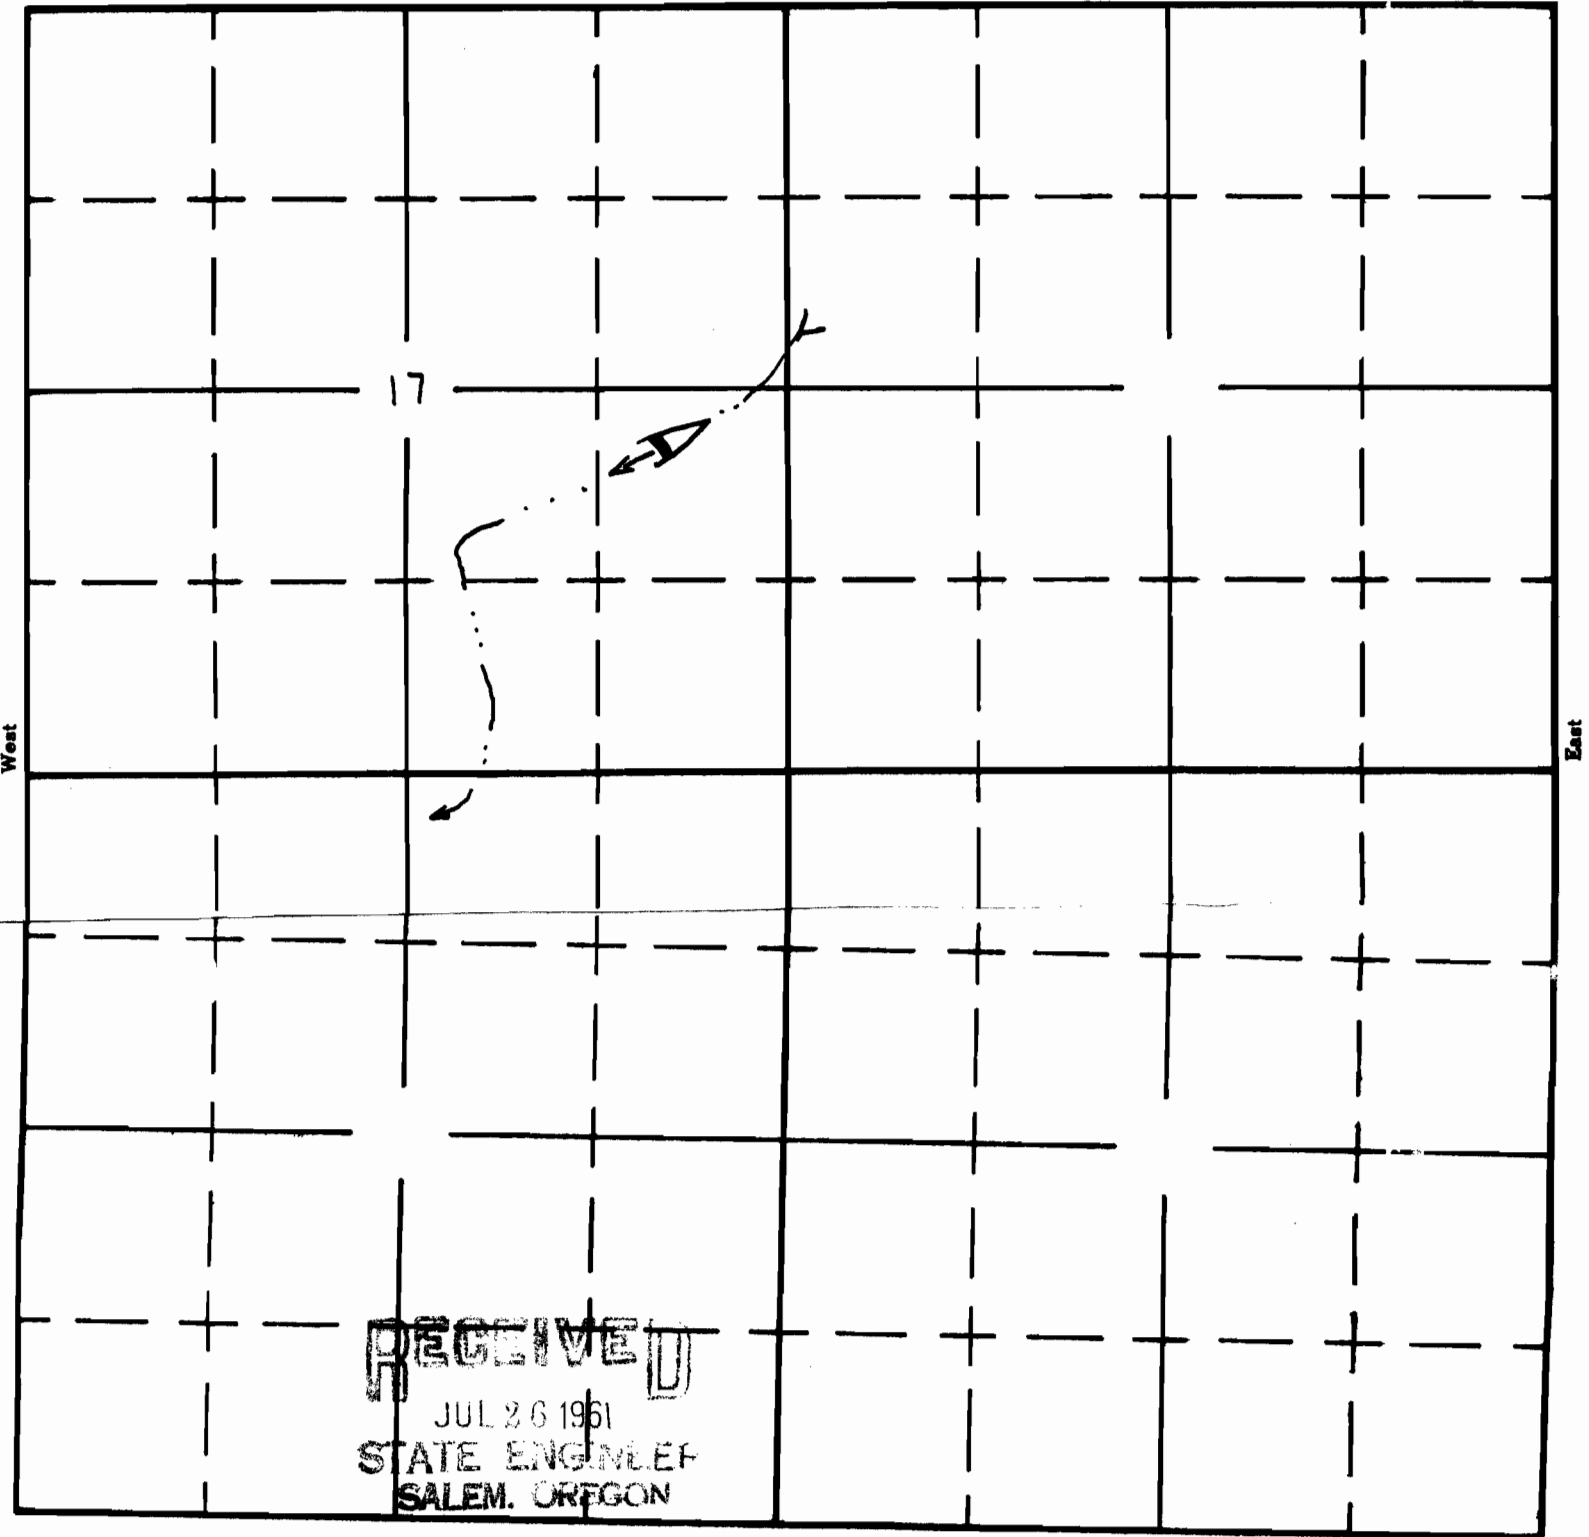

South

APPLICATION No. R-35532
PERMIT No. R-2815