

UNITED STATES
DEPARTMENT OF THE INTERIOR
BUREAU OF LAND MANAGEMENT

SECTION


NW 1/4 SW 1/4

Oregon State Water Filings

SEC. 35

TOWNSHIP 30 S, RANGE 34 E, W. M.

North

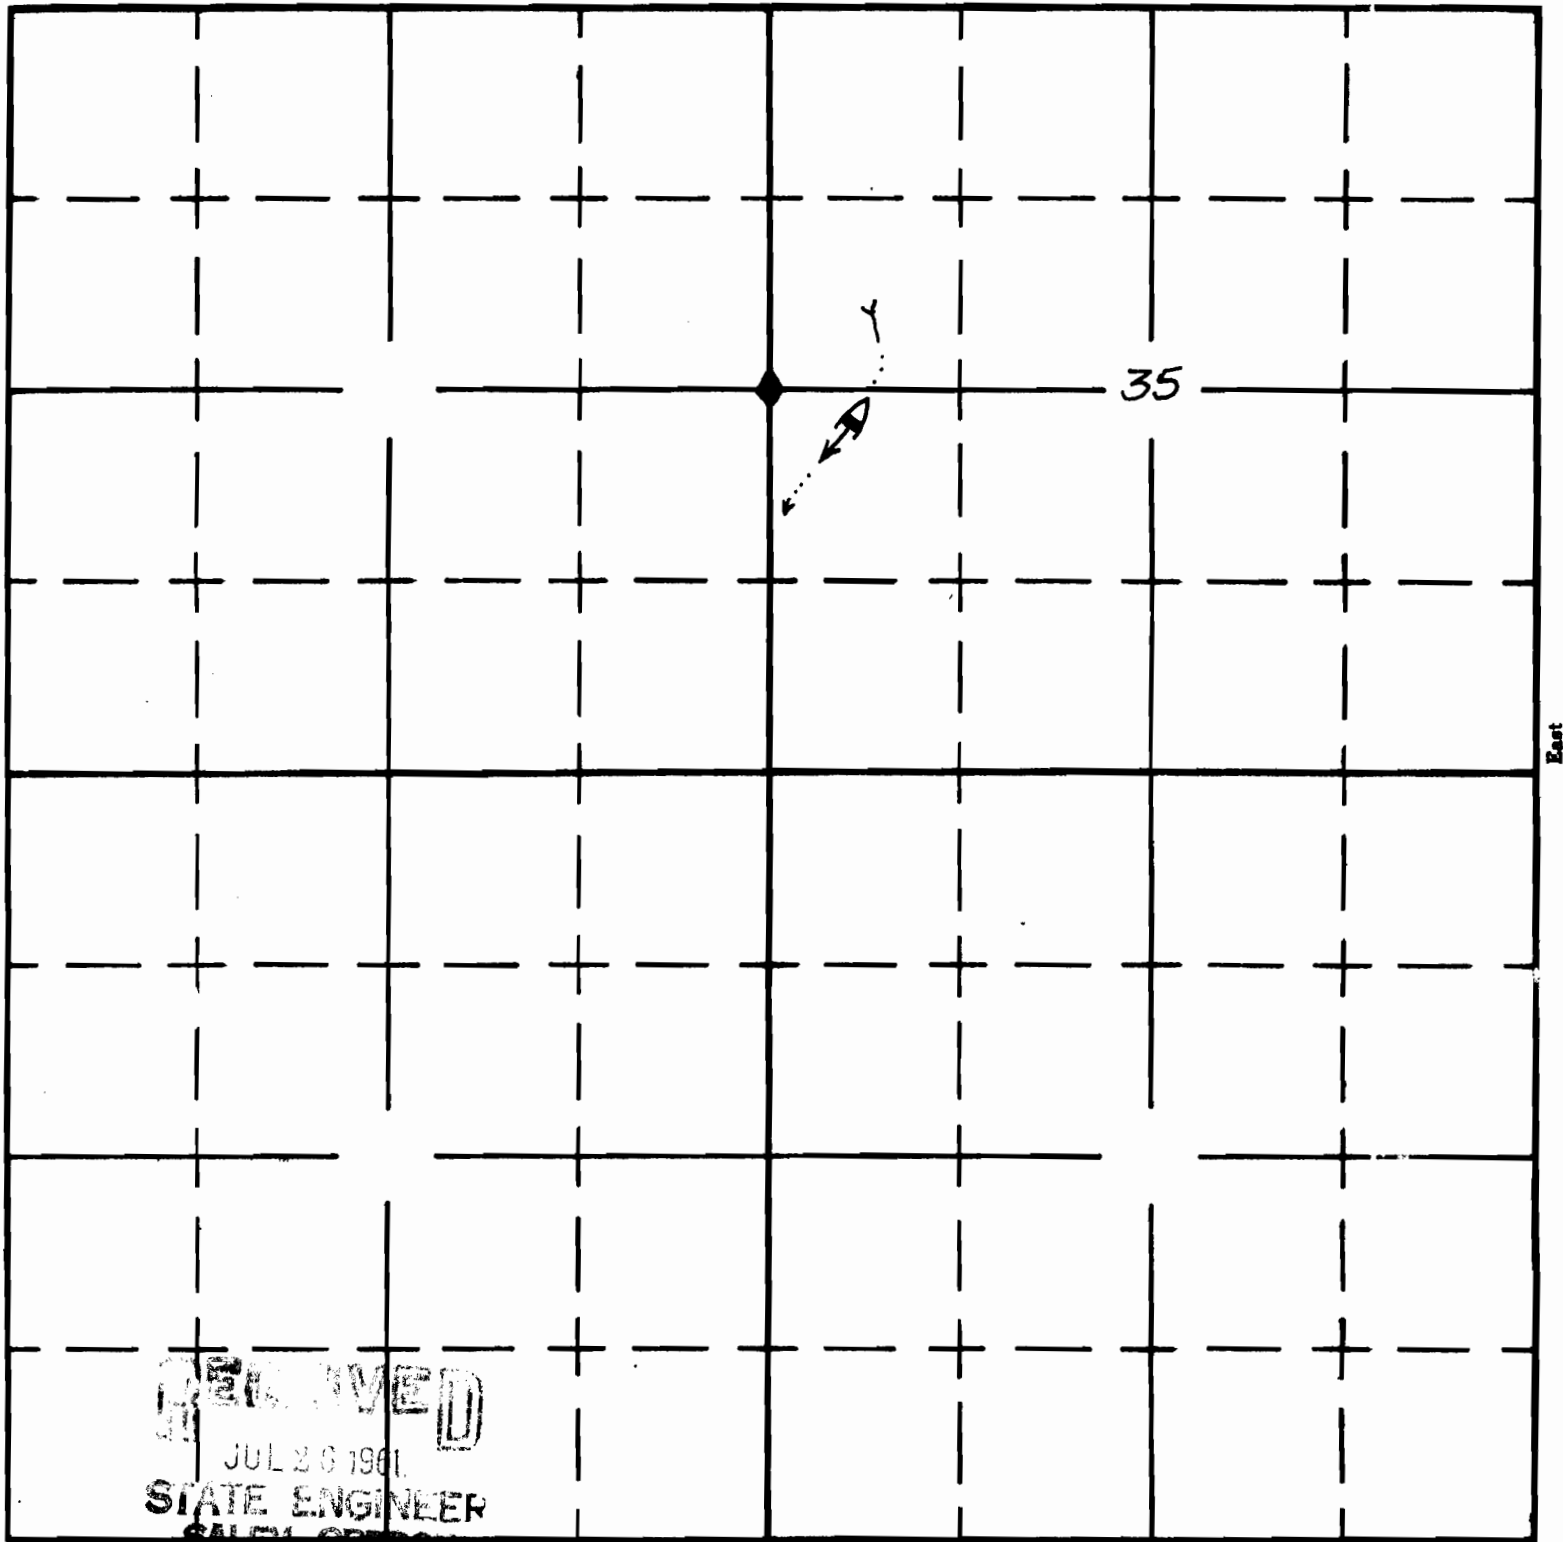

RECEIVED
JUL 20 1961
STATE ENGINEER
SALEM, OREGON

South

APPLICATION No. A-35538

PERMIT No. A-2881