

Form AI-187
March 1961

UNITED STATES
DEPARTMENT OF THE INTERIOR
BUREAU OF LAND MANAGEMENT

SECTION


NE $\frac{1}{4}$ NE $\frac{1}{4}$

SEC. 9

Oregon State Water Filings

TOWNSHIP 21 S, RANGE 30 E, W. M.

North

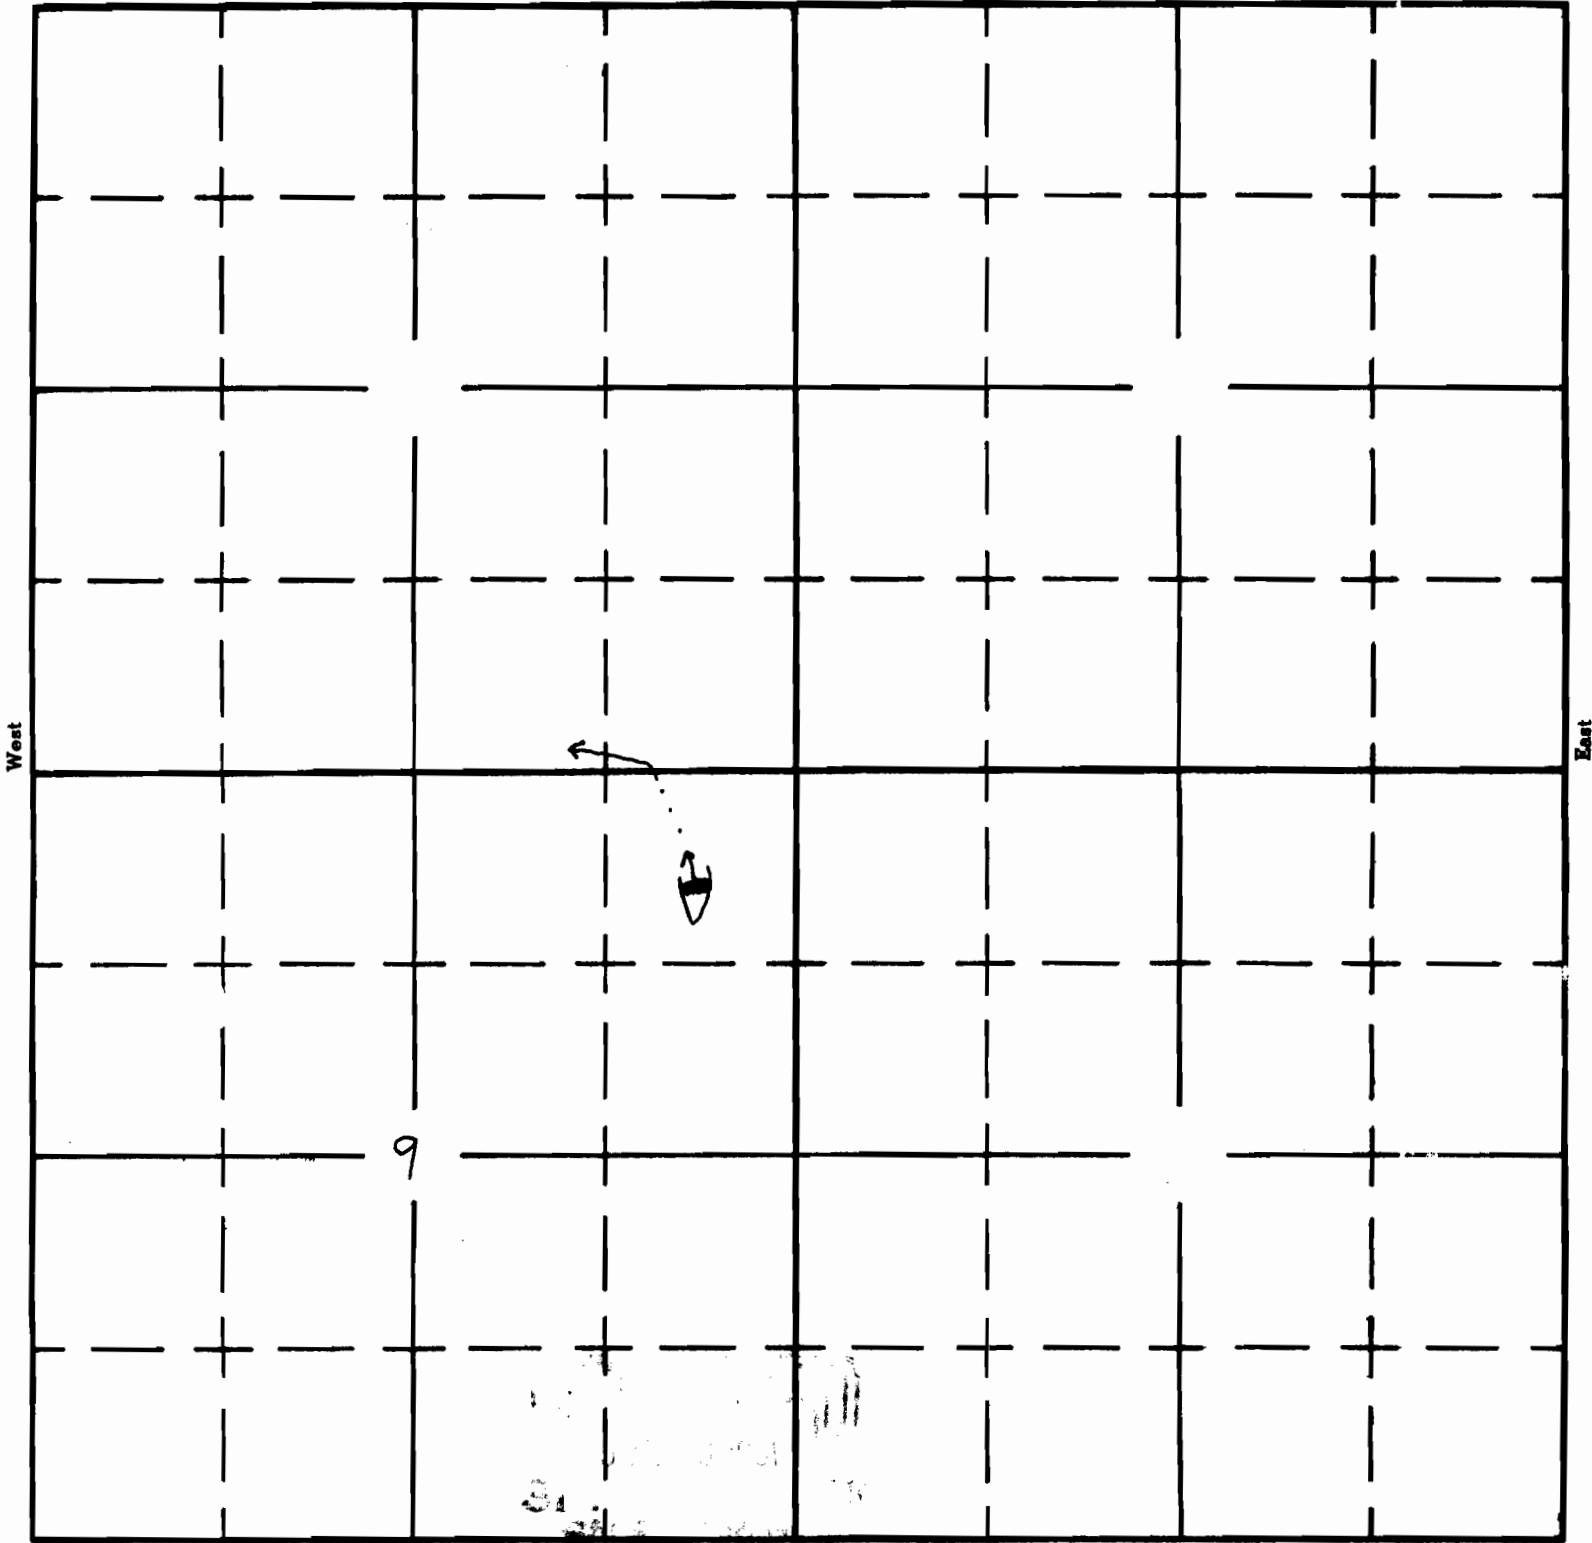

South

APPLICATION No. R-35562

PERMIT No. R-2905