

UNITED STATES
DEPARTMENT OF THE INTERIOR
BUREAU OF LAND MANAGEMENT

SECTION


SE $\frac{1}{4}$ NW $\frac{1}{4}$

SEC. 5

Oregon State Water Filings

TOWNSHIP 28 S, RANGE 34 E, W. M.

North

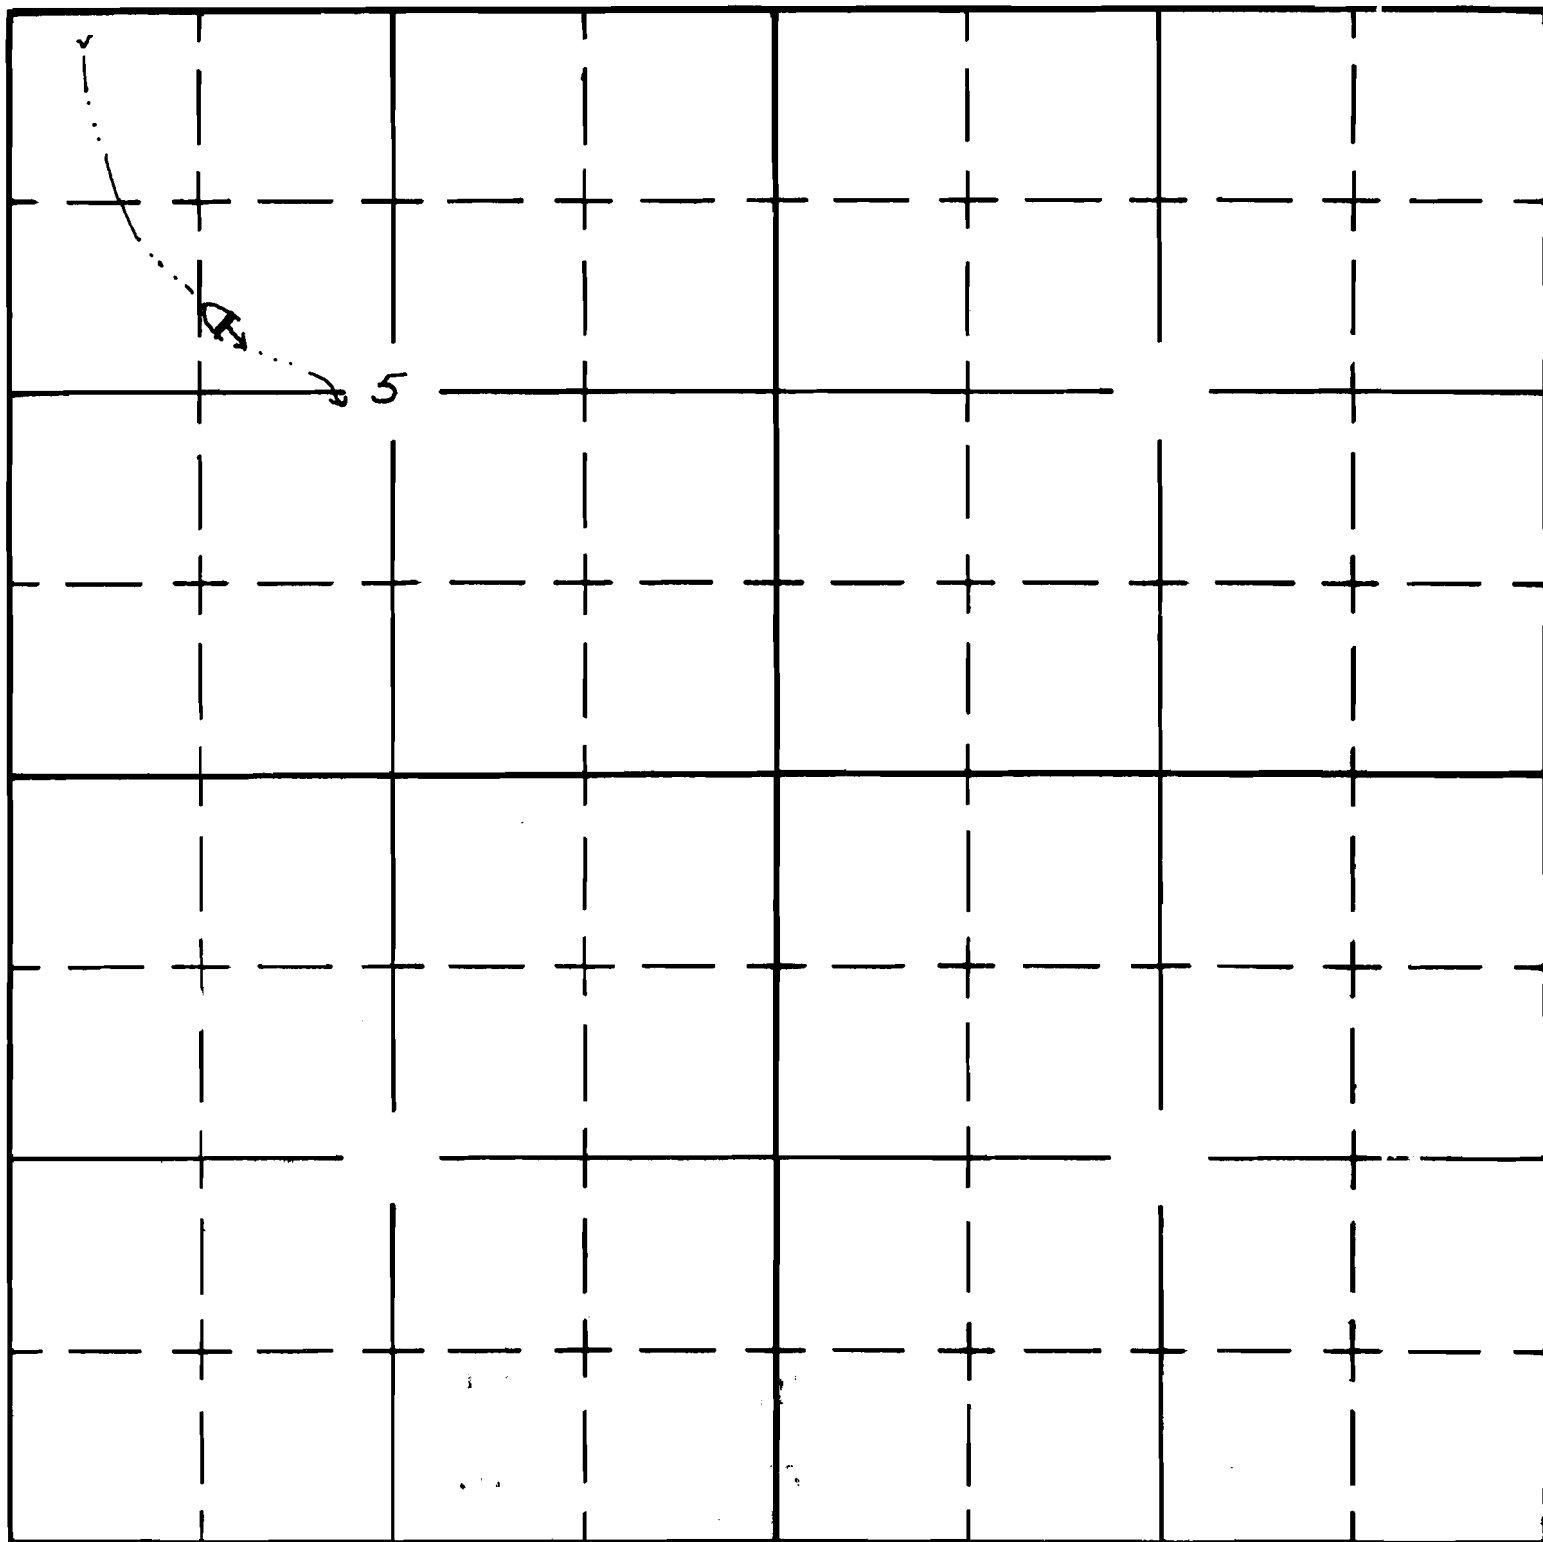

South

APPLICATION No. R-35768

PERMIT No. R-2407