

Form A1-187
March 1961

UNITED STATES
DEPARTMENT OF THE INTERIOR
BUREAU OF LAND MANAGEMENT

SECTION


NW¹ NW⁴

SEC. 6

Oregon State Water Filings

TOWNSHIP 22 S, RANGE 33 E, W. M.

North

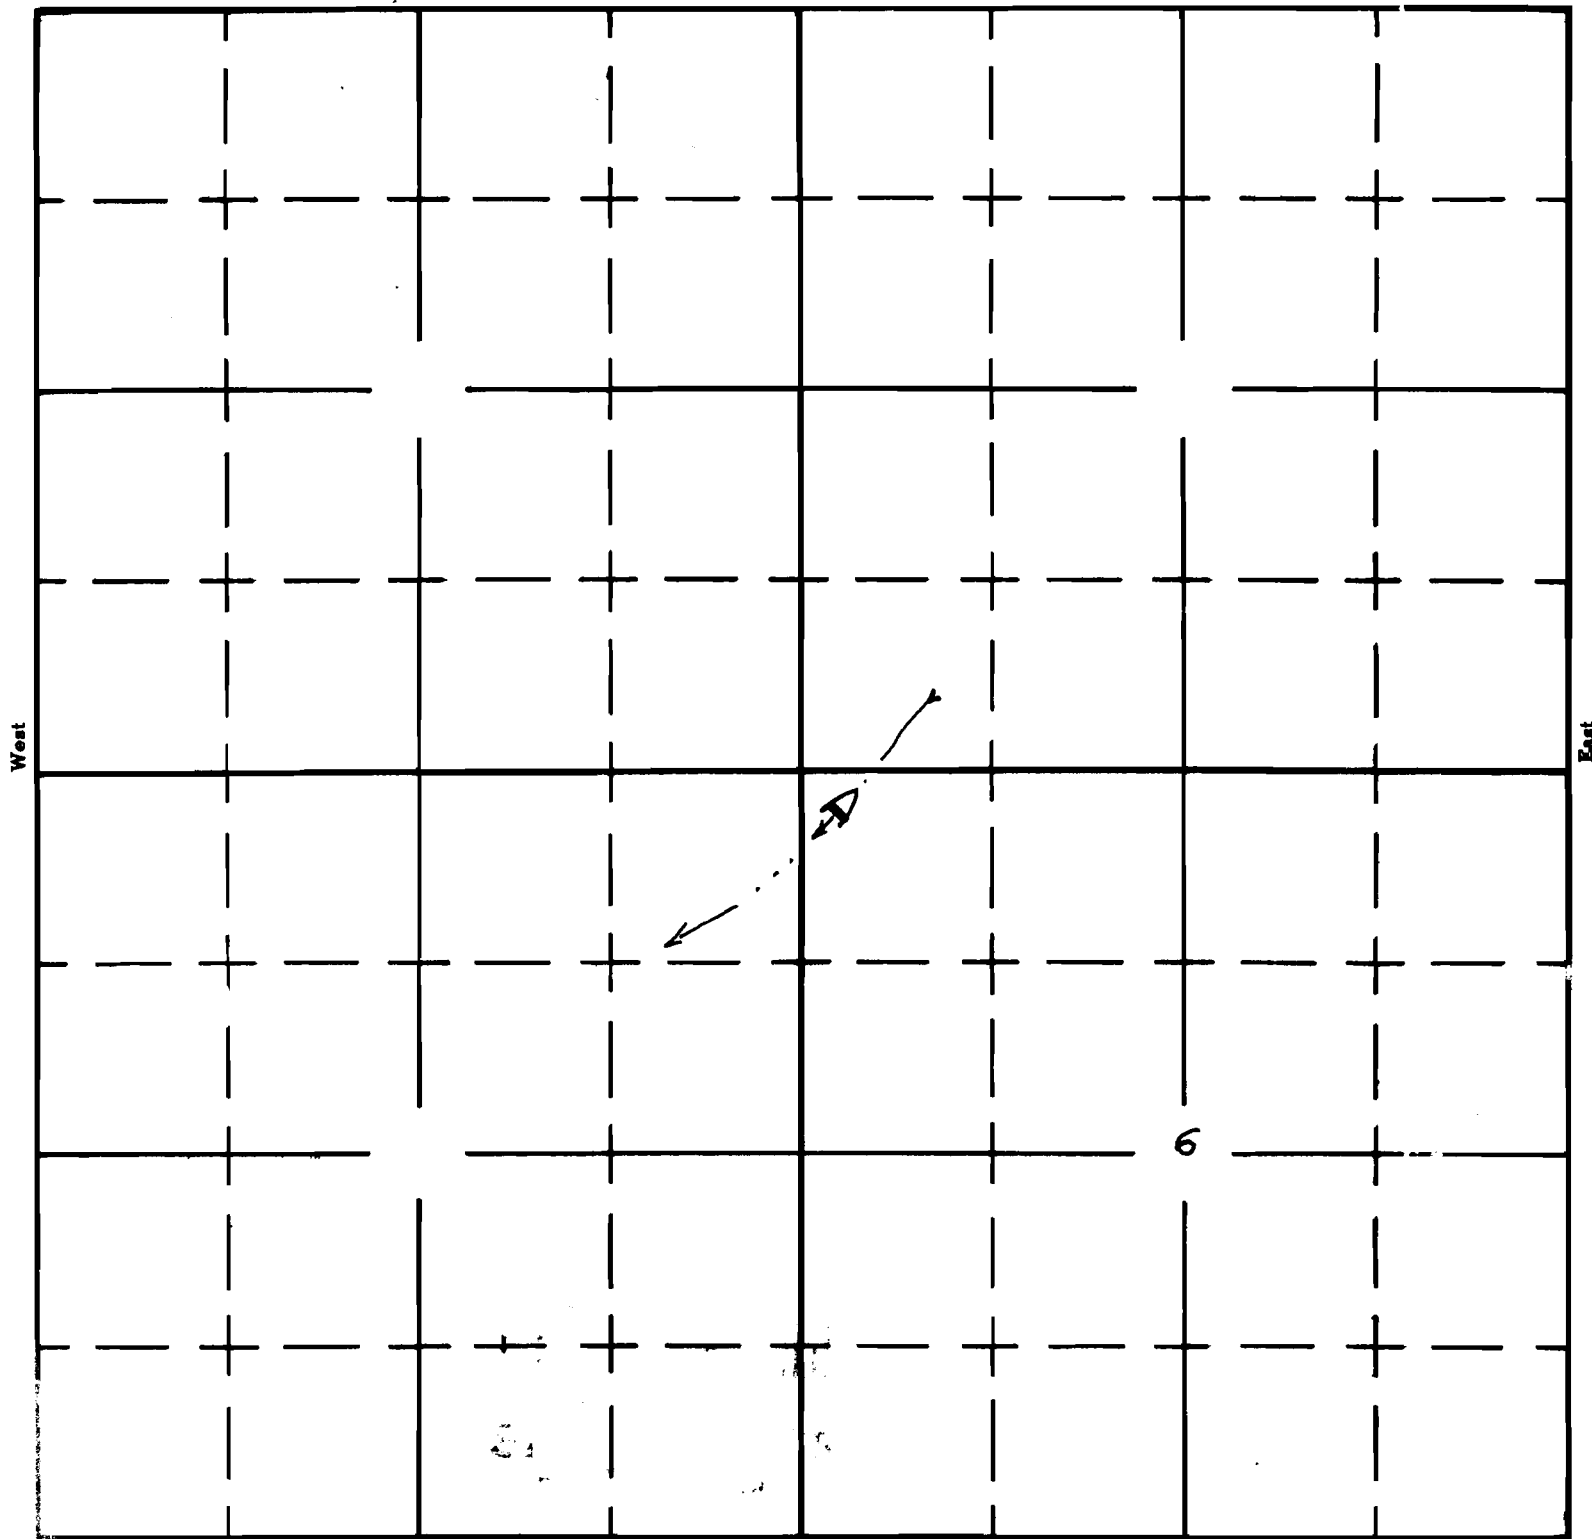

South

APPLICATION No. R-36571
PERMIT No. R-2912