

Form AI-187
March 1961

UNITED STATES
DEPARTMENT OF THE INTERIOR
BUREAU OF LAND MANAGEMENT

SECTION


SW 1/4 NW 1/4

SEC 1

Oregon State Water Filings

TOWNSHIP 21 S, RANGE 32 E, W. M.

North

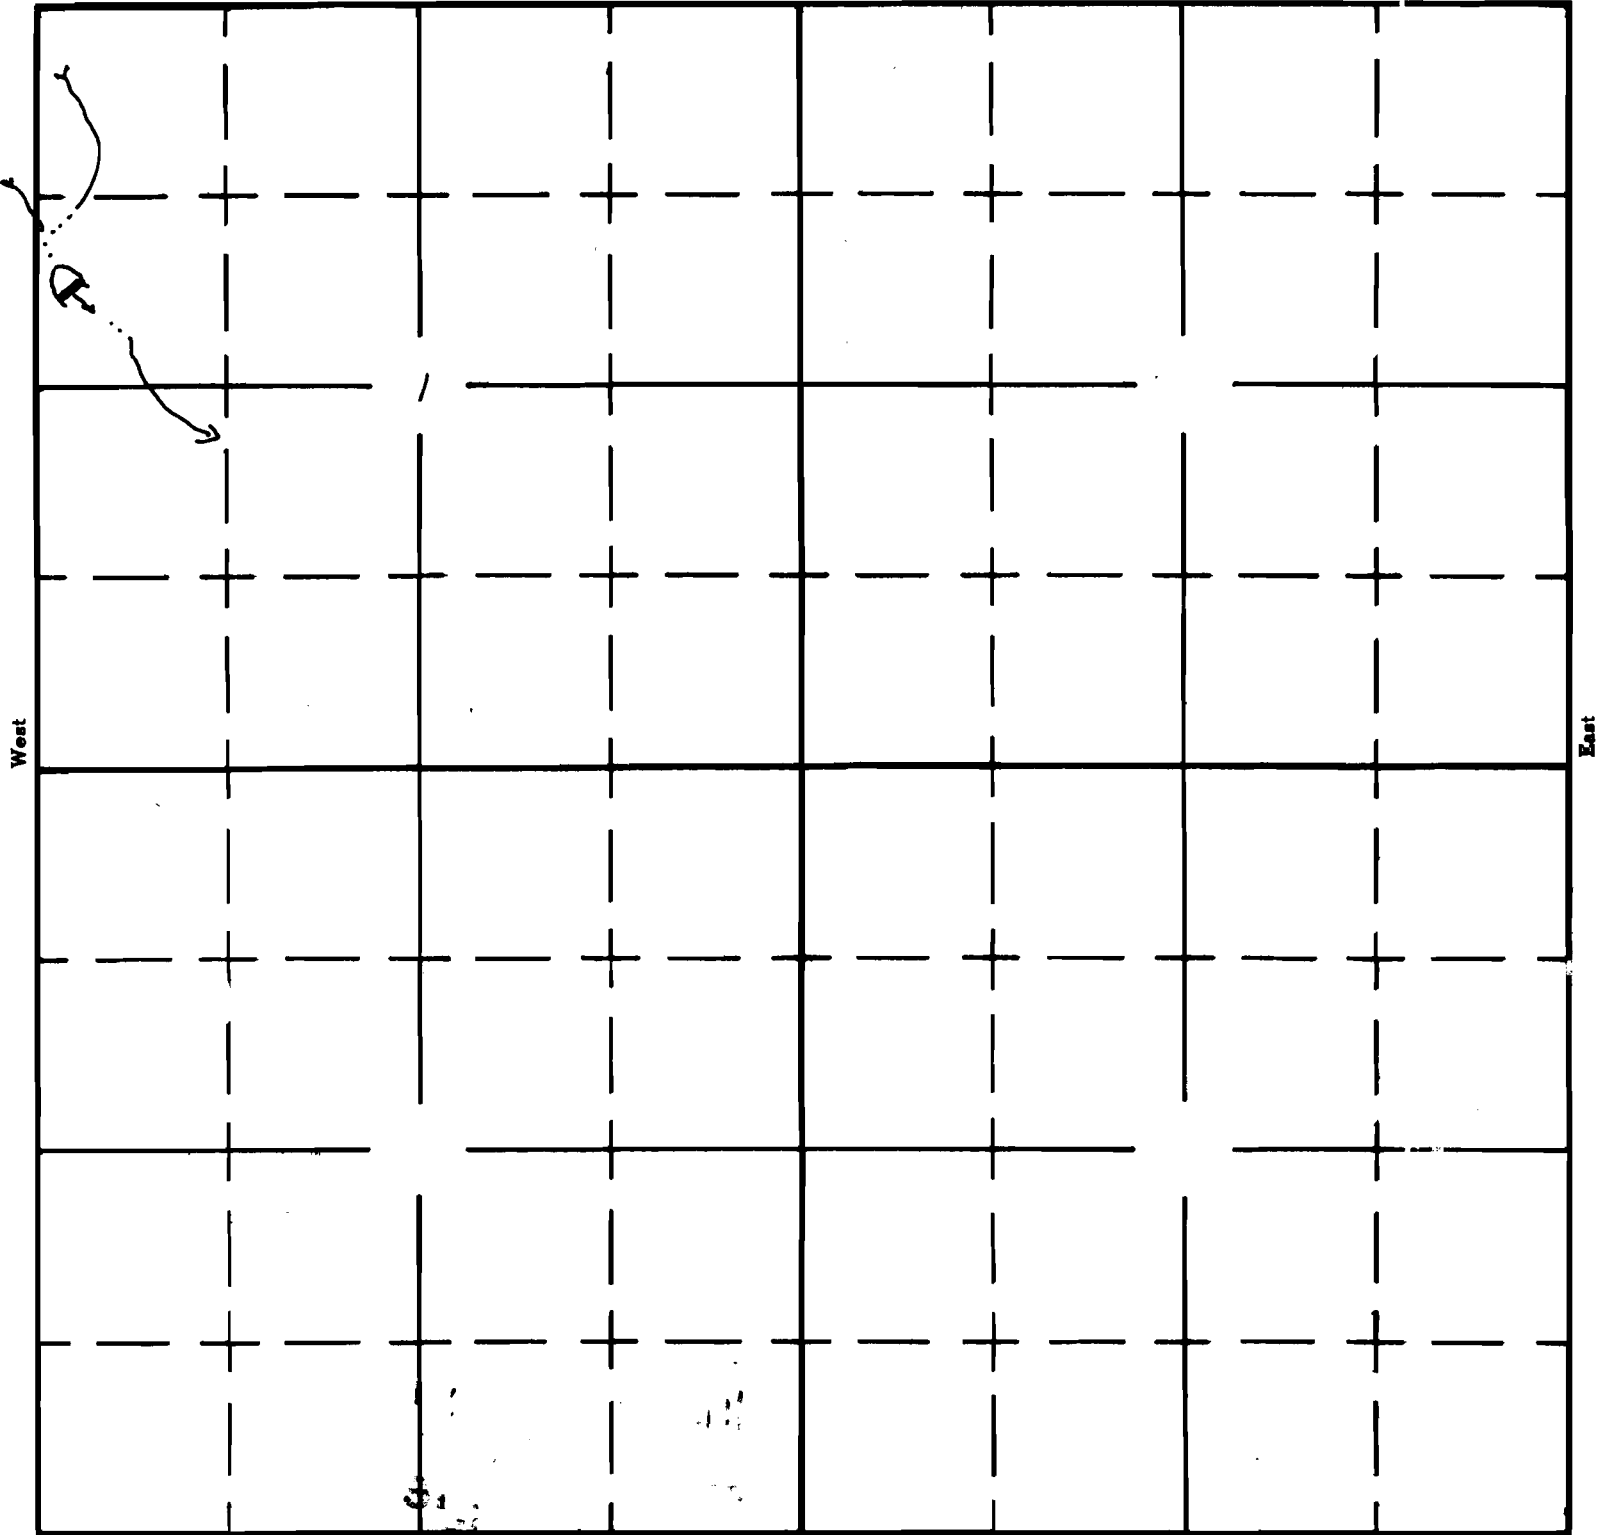

South

APPLICATION No. R-35576

PERMIT No. R-2917