

UNITED STATES
DEPARTMENT OF THE INTERIOR
BUREAU OF LAND MANAGEMENT

SECTION


SW $\frac{1}{4}$ SW $\frac{1}{4}$

Oregon State Water Filings

Sec. 32

TOWNSHIP 29S, RANGE 34E, W. M.

North

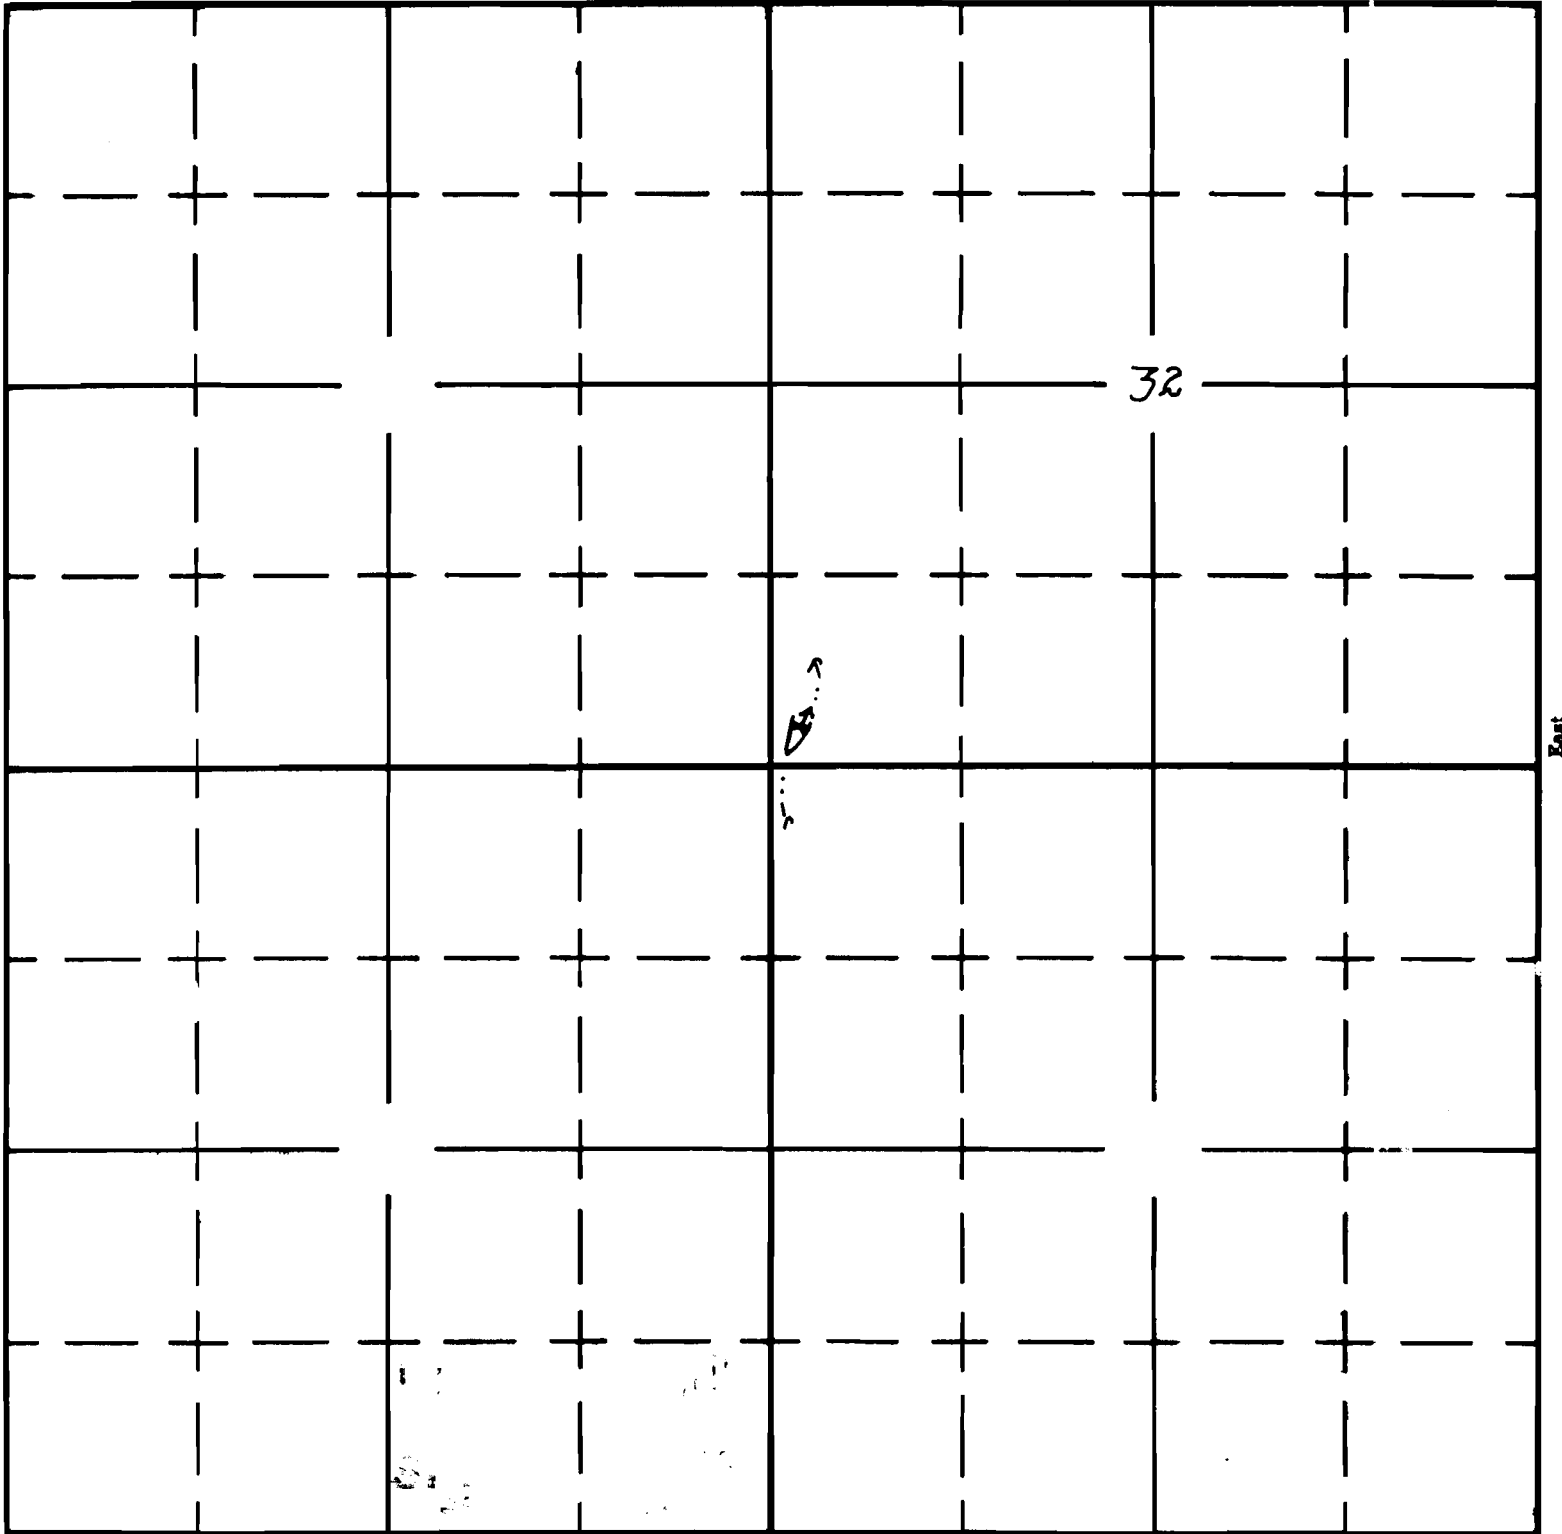

South

APPLICATION No. R-35578

PERMIT No. R-2917