

UNITED STATES
DEPARTMENT OF THE INTERIOR
BUREAU OF LAND MANAGEMENT

SECTION


E³ SE⁴

Oregon State Water Filings

SEC. 5

TOWNSHIP 30S, RANGE 34E, W. M.

North

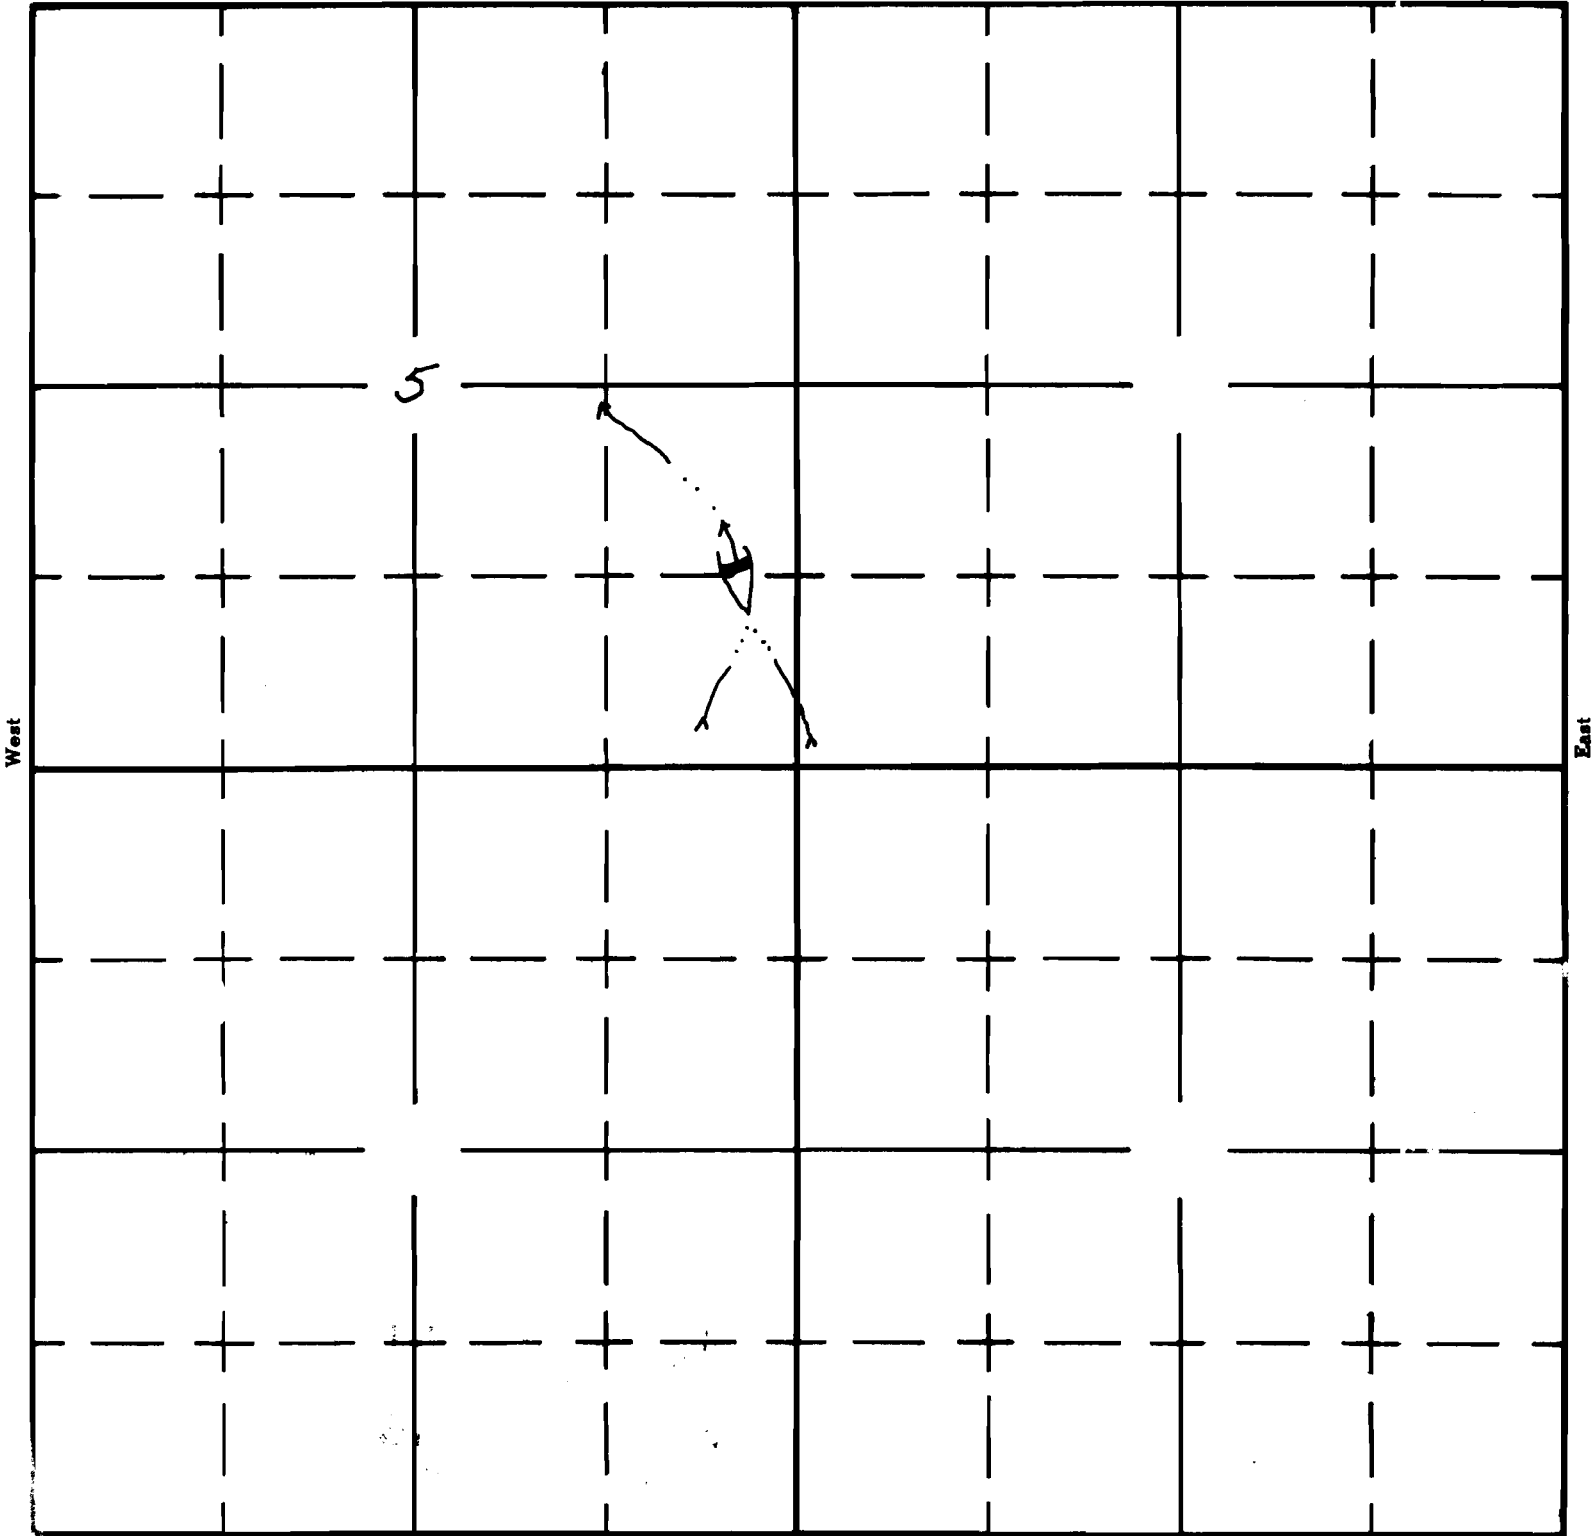

South

APPLICATION No. R-35579
PERMIT No. R-2920