

UNITED STATES
DEPARTMENT OF THE INTERIOR
BUREAU OF LAND MANAGEMENT

SECTION


NW 1/4 SW 1/4

Oregon State Water Filings

SEC 19

TOWNSHIP 30S, RANGE 34E, W. M.

North

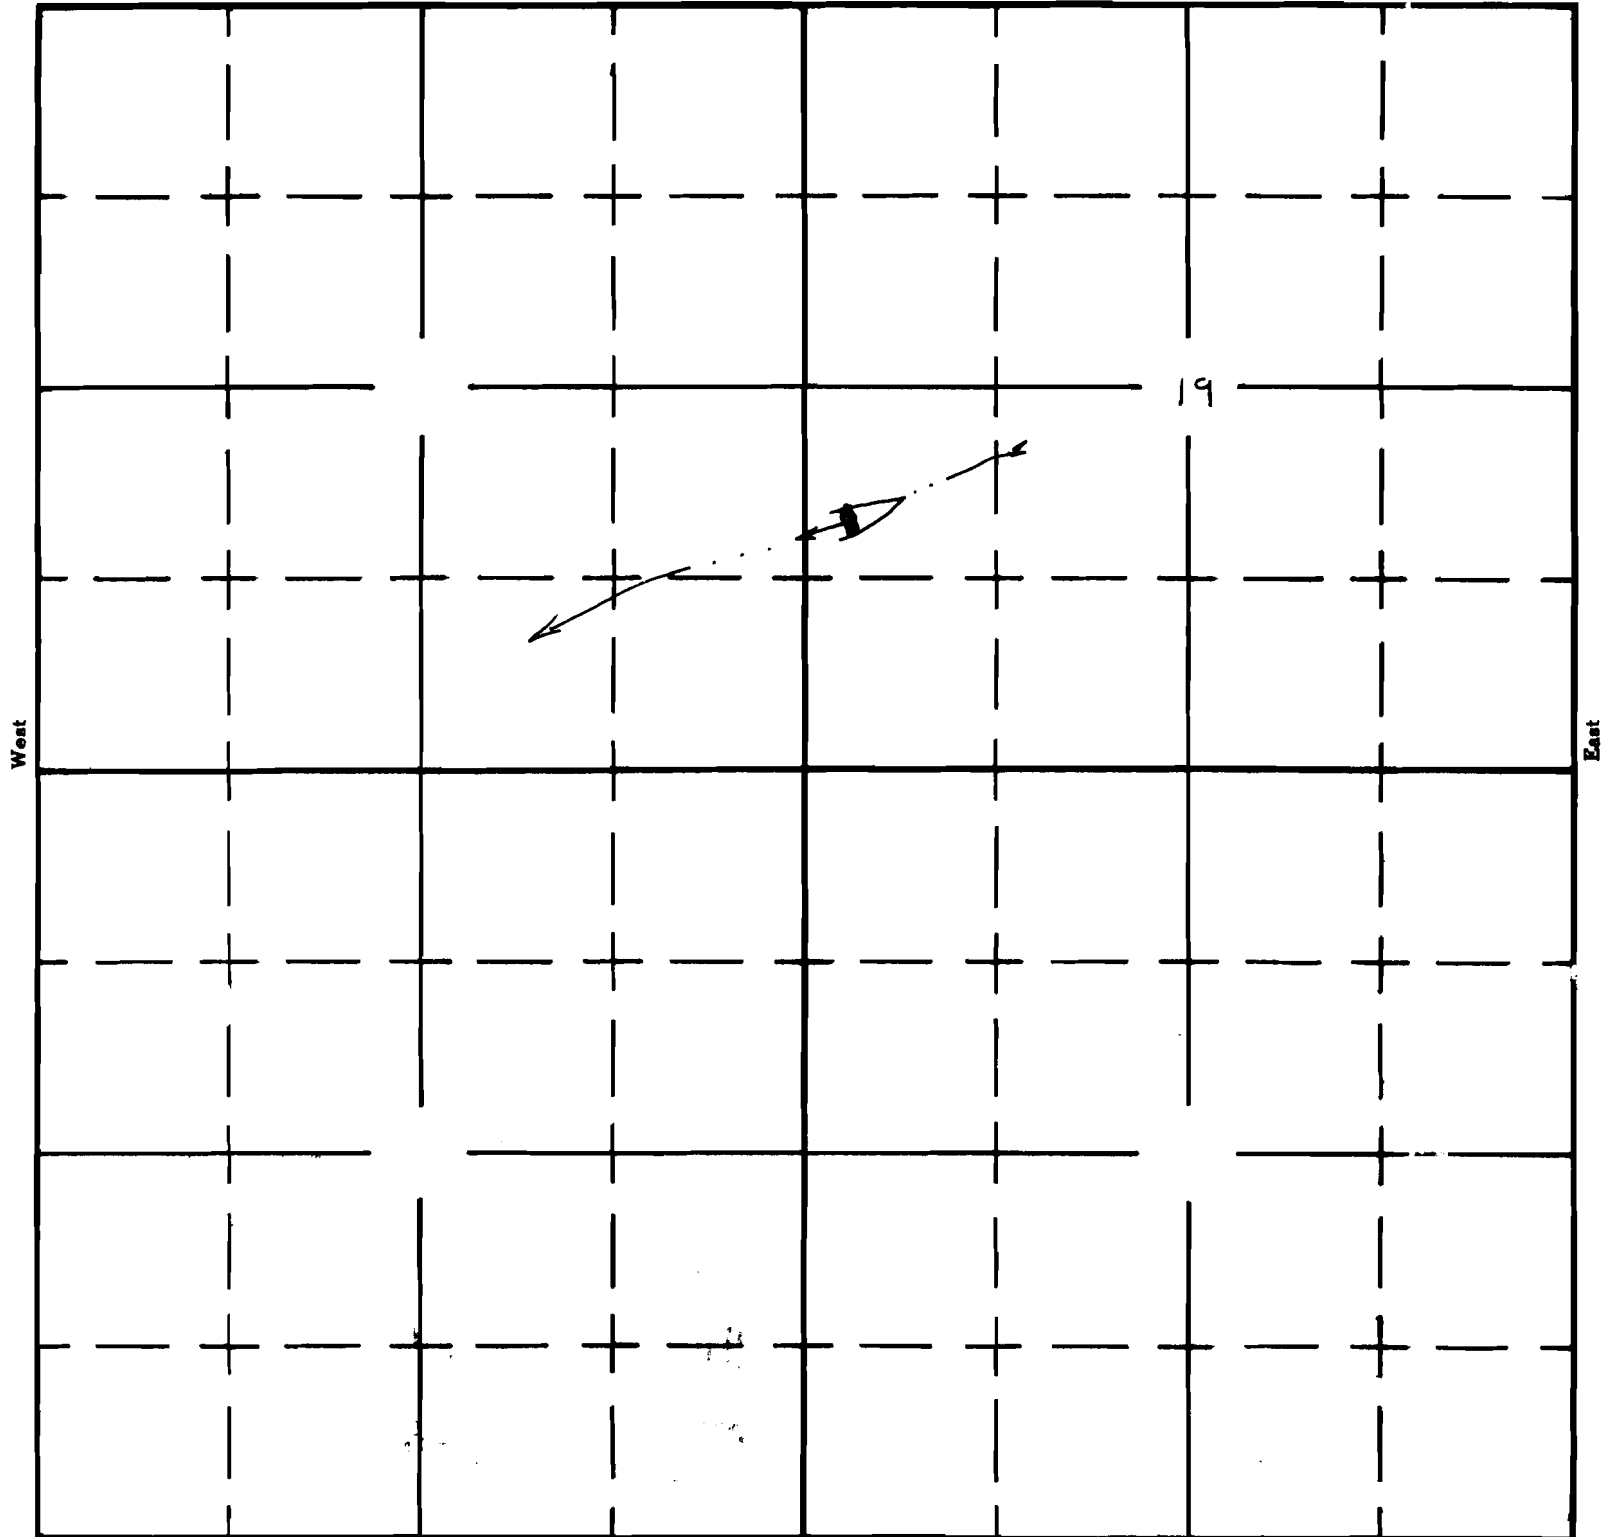

South

APPLICATION No. R-35580

PERMIT No. R-2921