

UNITED STATES
DEPARTMENT OF THE INTERIOR
BUREAU OF LAND MANAGEMENT

SECTION


SE $\frac{1}{4}$ SE $\frac{1}{4}$

SEC. 14

Oregon State Water Filings

TOWNSHIP 23S, RANGE 28E, W. M.

North

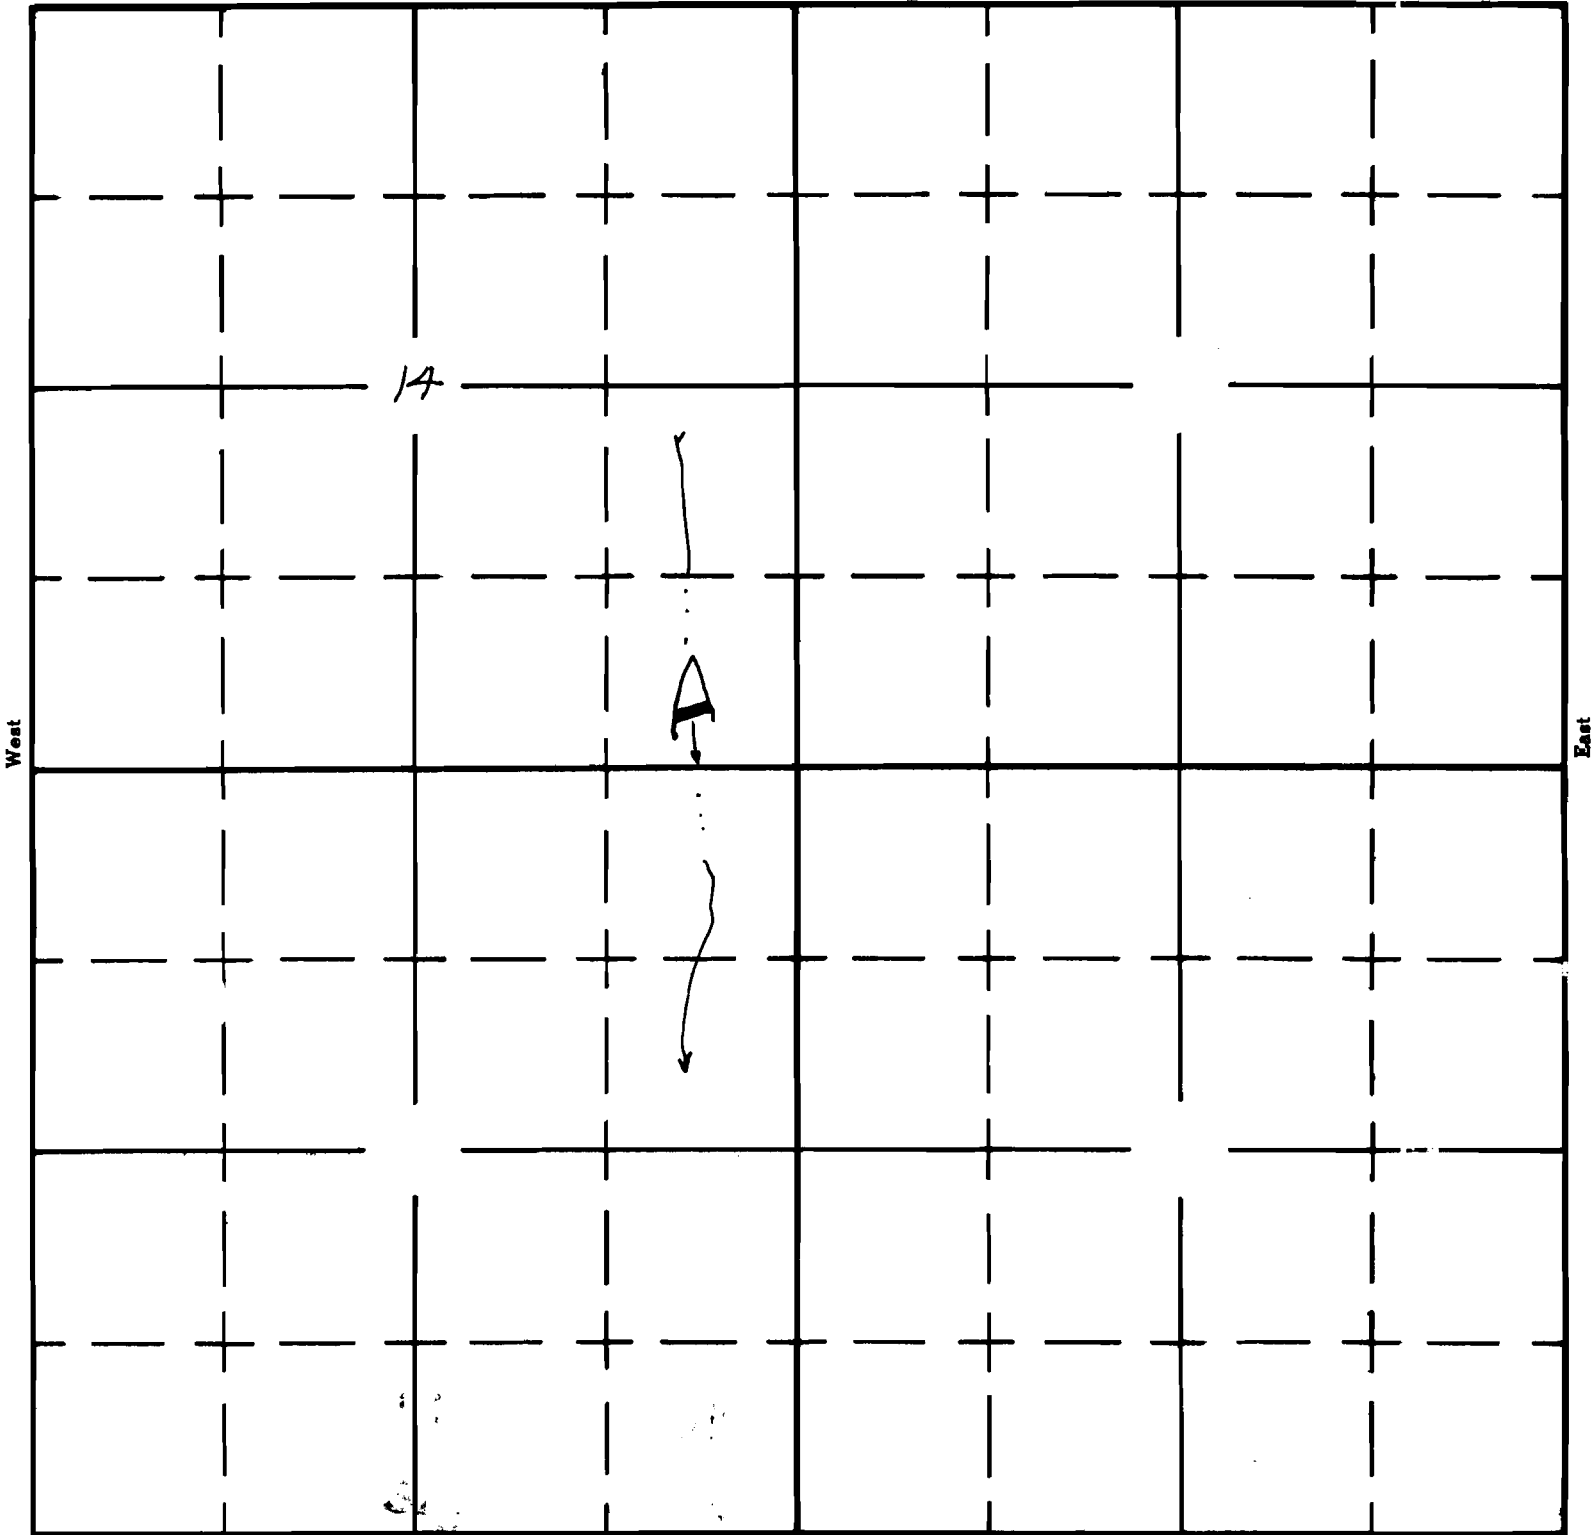

South

APPLICATION No. R-35583

PERMIT No. R-2924