

Form AI-187
March 1961

UNITED STATES
DEPARTMENT OF THE INTERIOR
BUREAU OF LAND MANAGEMENT

SECTION


SW 1/4 NE 1/4

SEC. 29

Oregon State Water Filings

TOWNSHIP 29S, RANGE 36E, W. M.

North

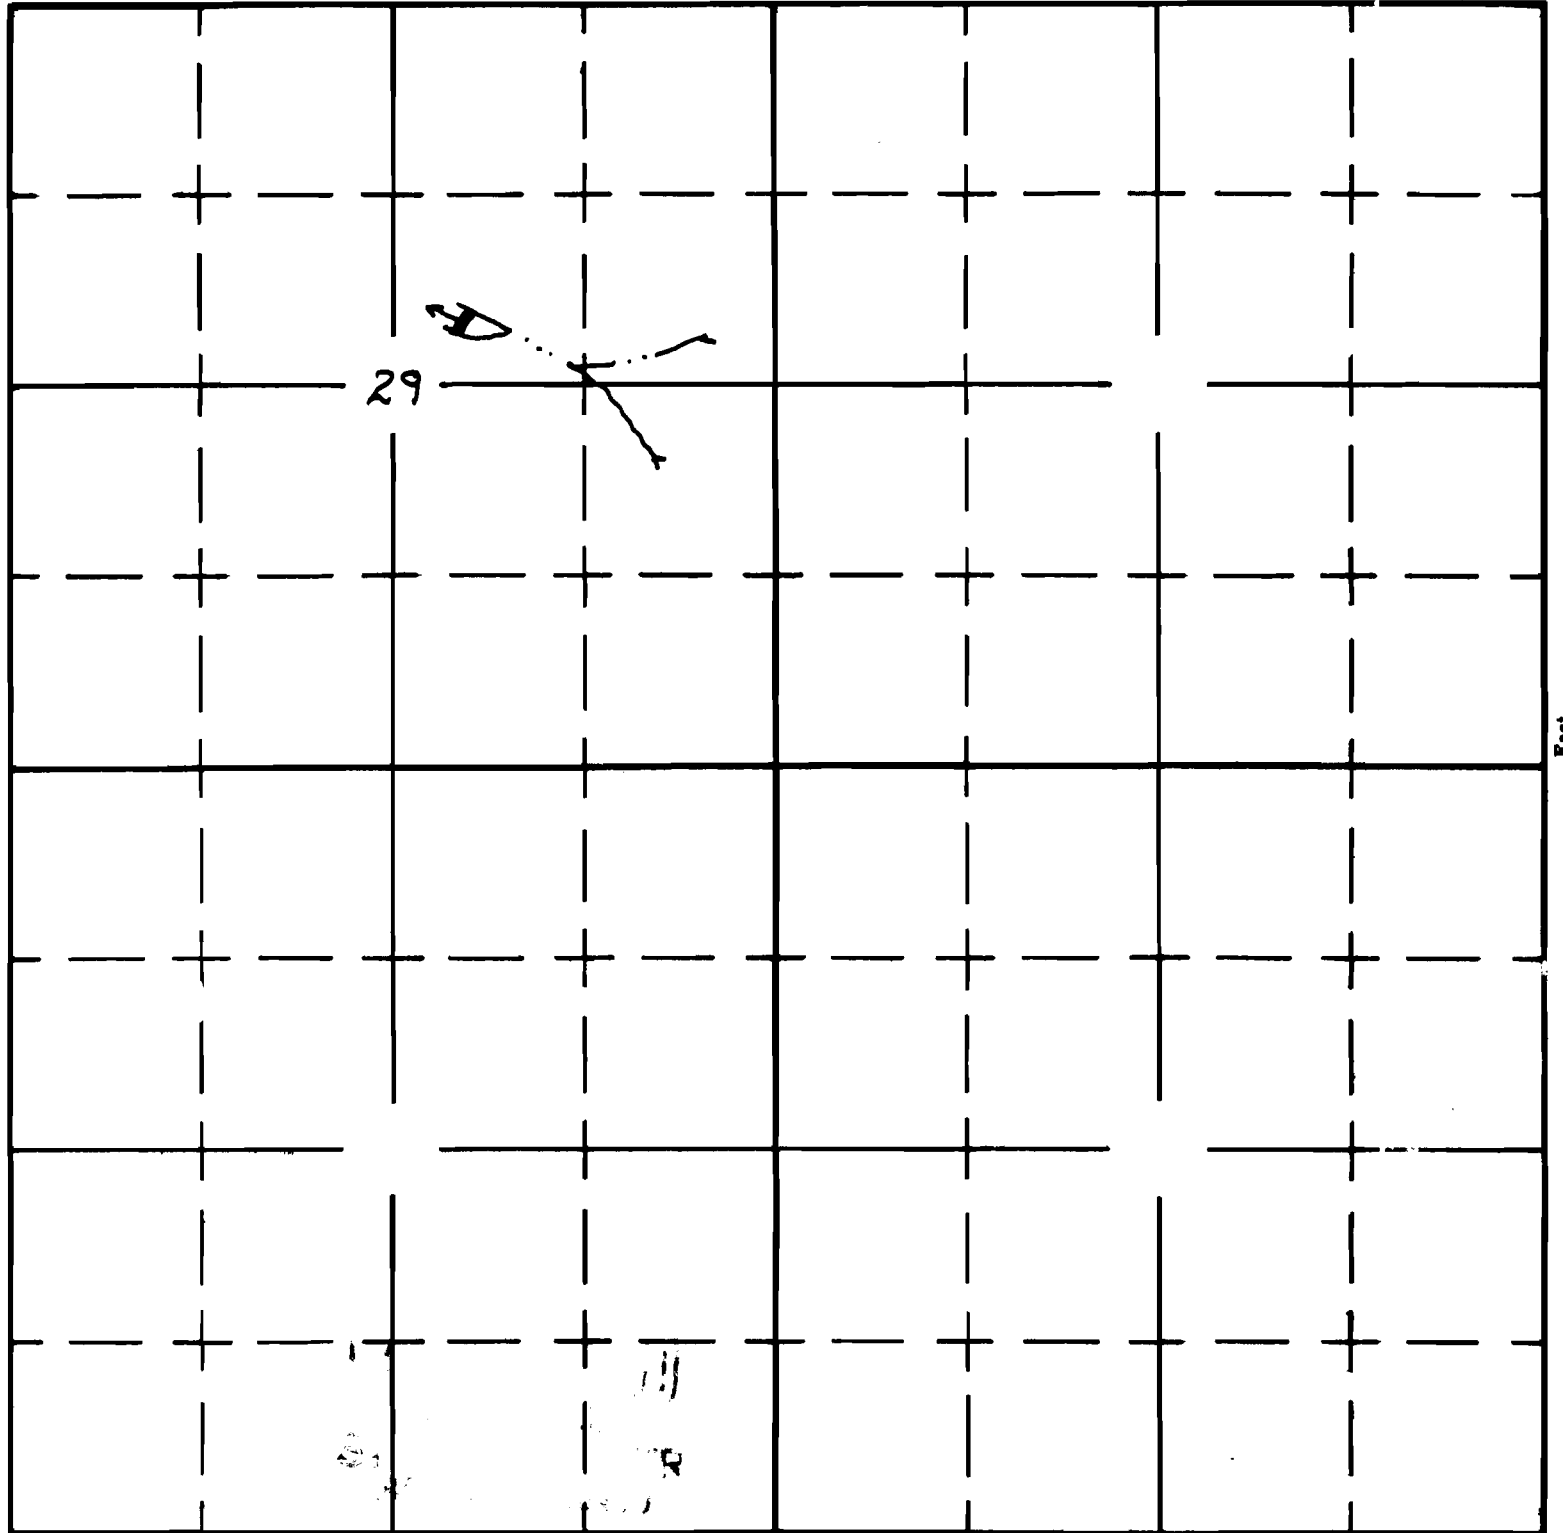

South

APPLICATION No. R-35595
PERMIT No. R-2936