

Form A1-187
March 1961

UNITED STATES
DEPARTMENT OF THE INTERIOR
BUREAU OF LAND MANAGEMENT

SECTION


SW $\frac{1}{4}$ NE $\frac{1}{4}$

33

Oregon State Water Filings

TOWNSHIP 20S, RANGE 30E, W. M.

North

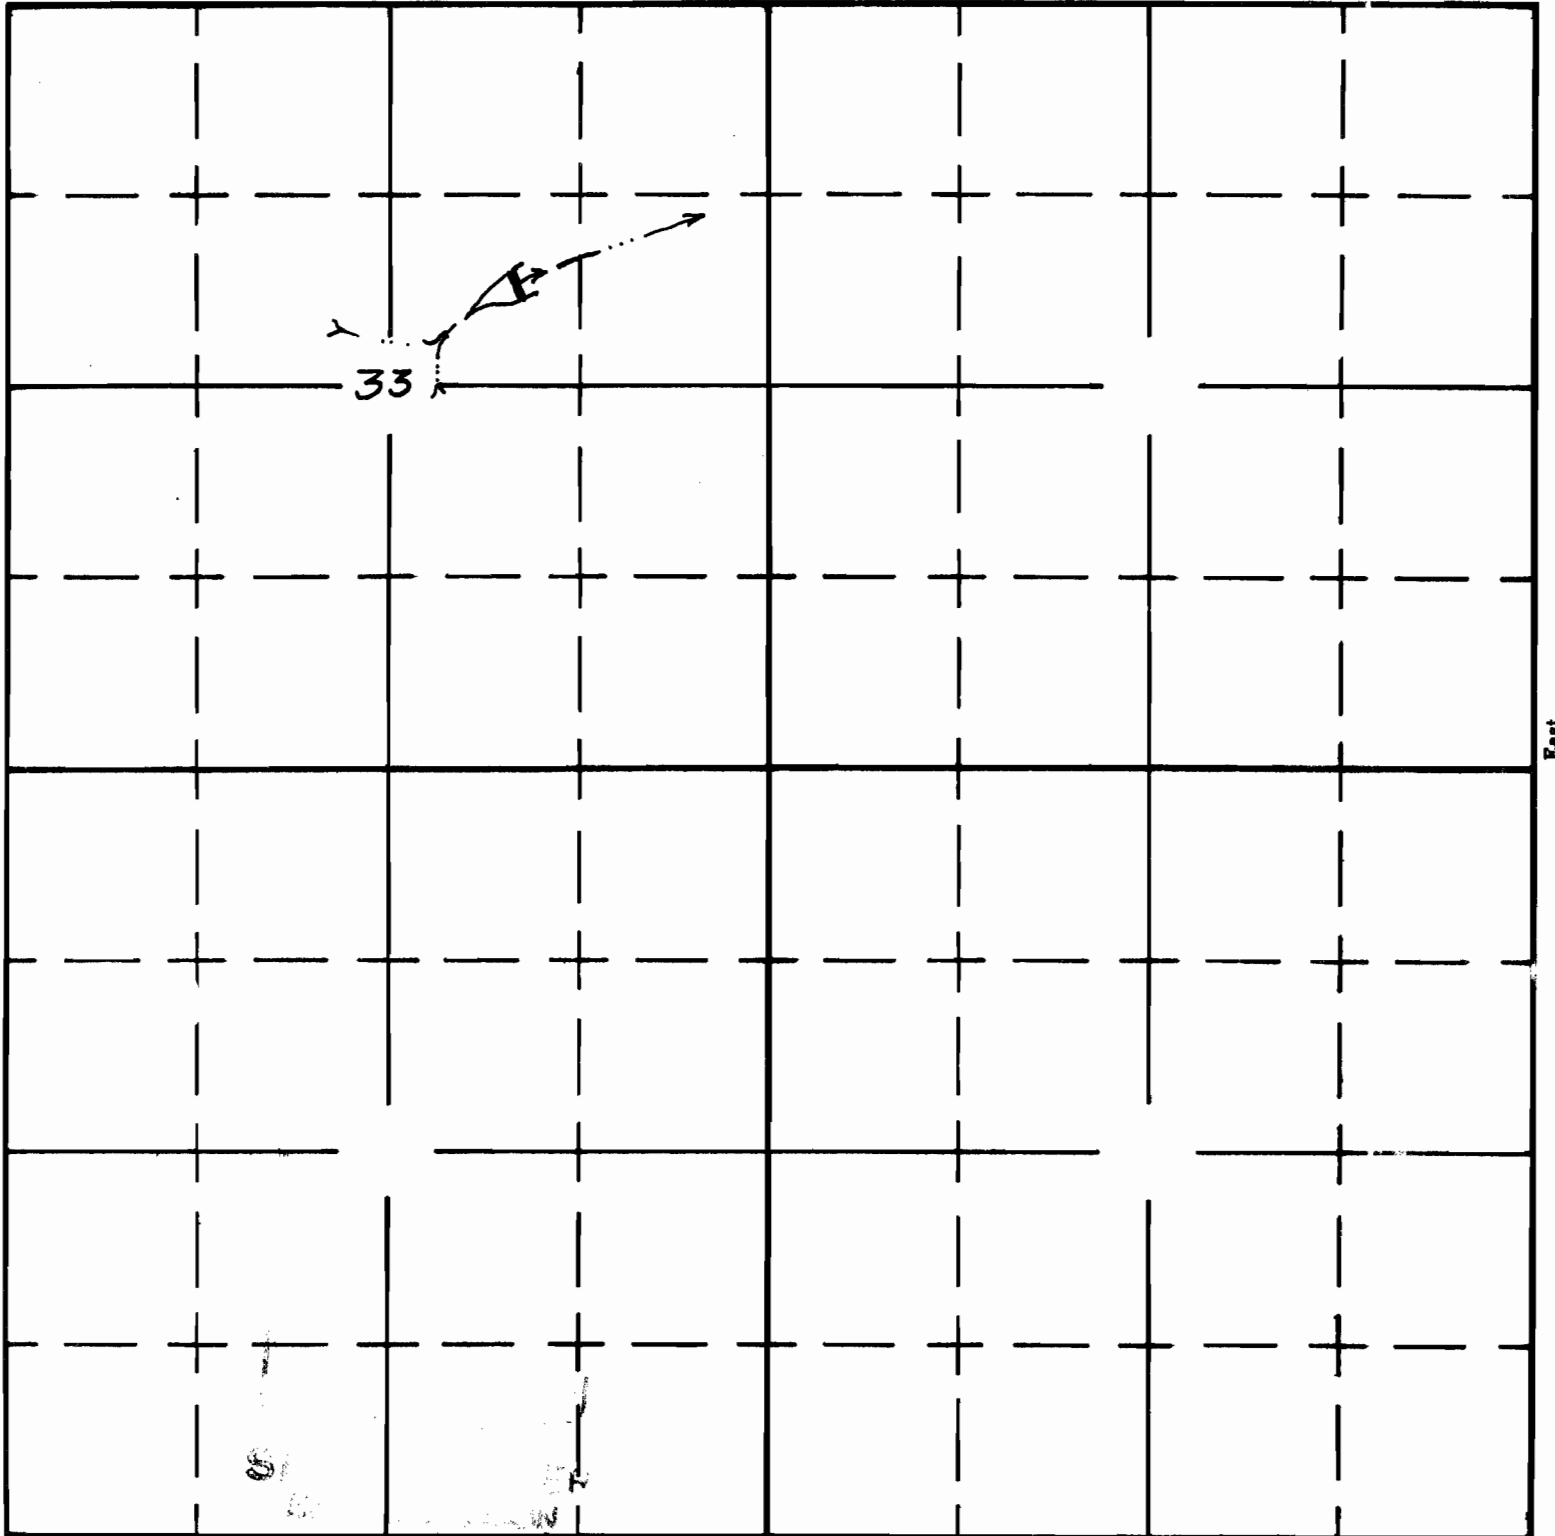

South

APPLICATION No. R-35333
PERMIT No. R-3097