

UNITED STATES
DEPARTMENT OF THE INTERIOR
BUREAU OF LAND MANAGEMENT

SECTION


SW 1/4 SE 1/4

Oregon State Water Filings

SEC. 11

TOWNSHIP 29S, RANGE 32E, W. M.

North

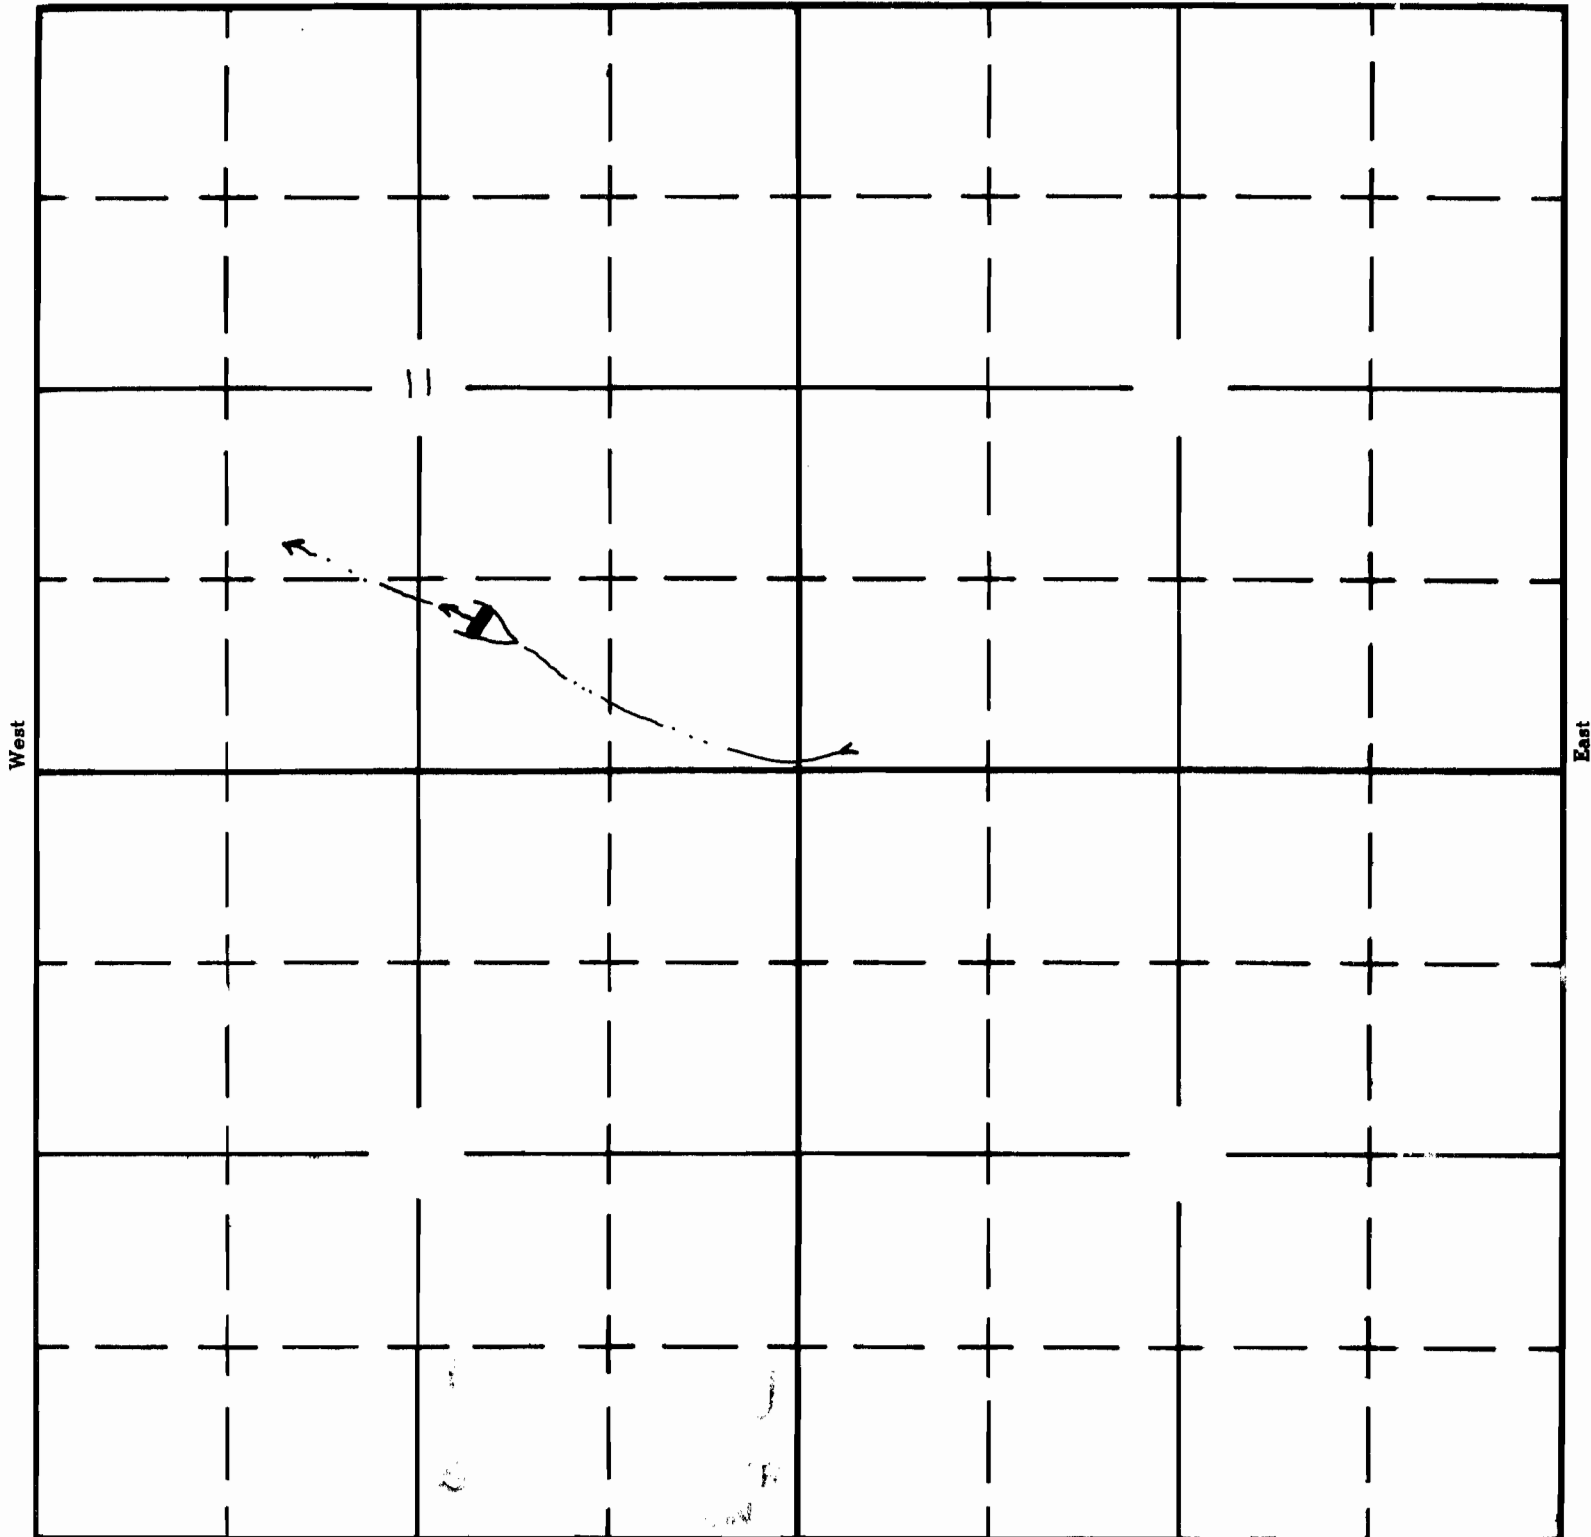

South

APPLICATION No. R-35350

PERMIT No. R-3105