

Form A1-187
March 1961

UNITED STATES
DEPARTMENT OF THE INTERIOR
BUREAU OF LAND MANAGEMENT

SECTION


SE $\frac{1}{4}$ NE $\frac{1}{4}$

Oregon State Water Filings

SEC. 28

TOWNSHIP 30 S, RANGE 34 E, W. M.

North

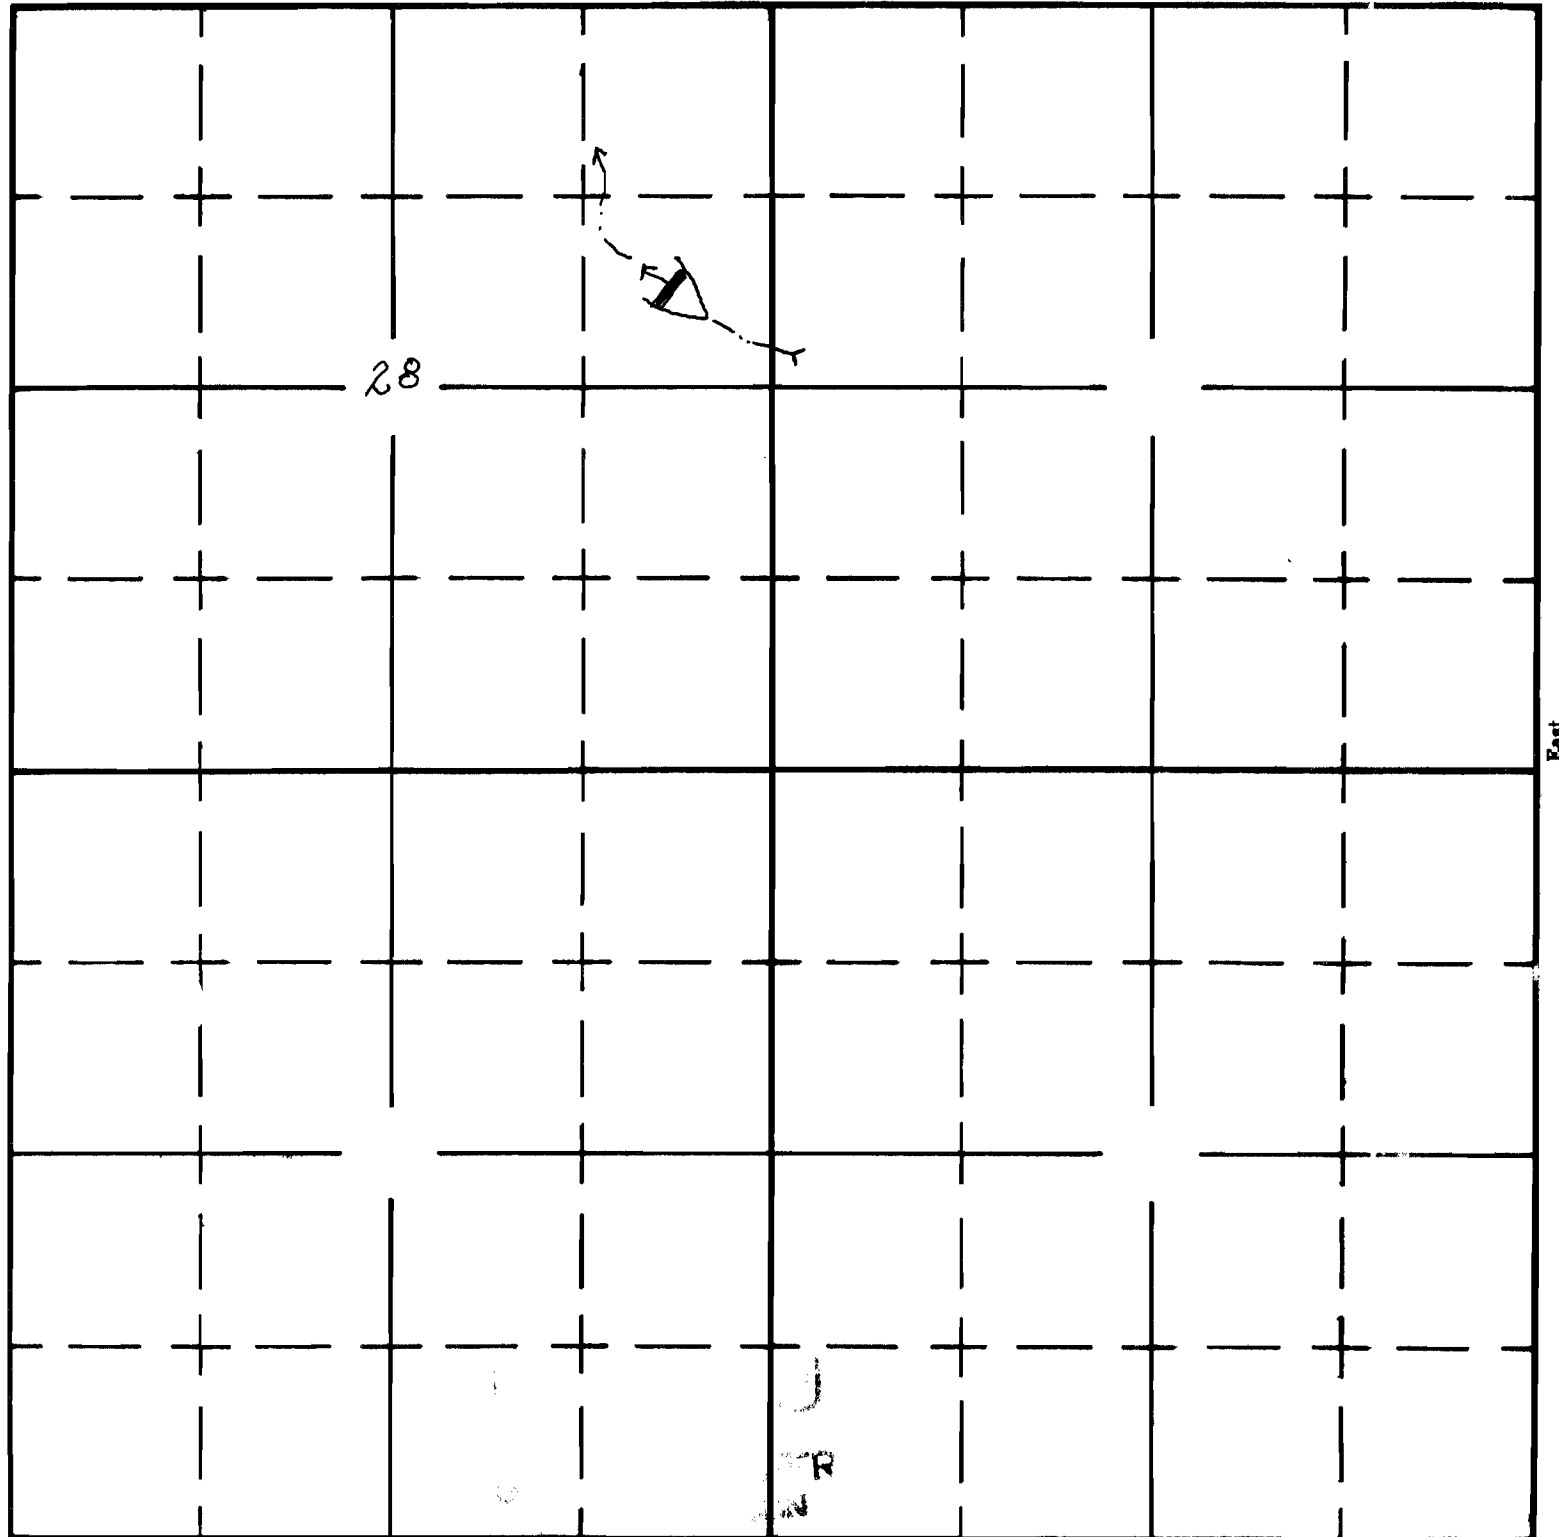

South

APPLICATION No. R-35352
PERMIT No. R-3107