

UNITED STATES
DEPARTMENT OF THE INTERIOR
BUREAU OF LAND MANAGEMENT


SECTION

NE 1/4 SE 1/4

Oregon State Water Filings

SEC. 33

TOWNSHIP 30 S, RANGE 34 E, W. M.

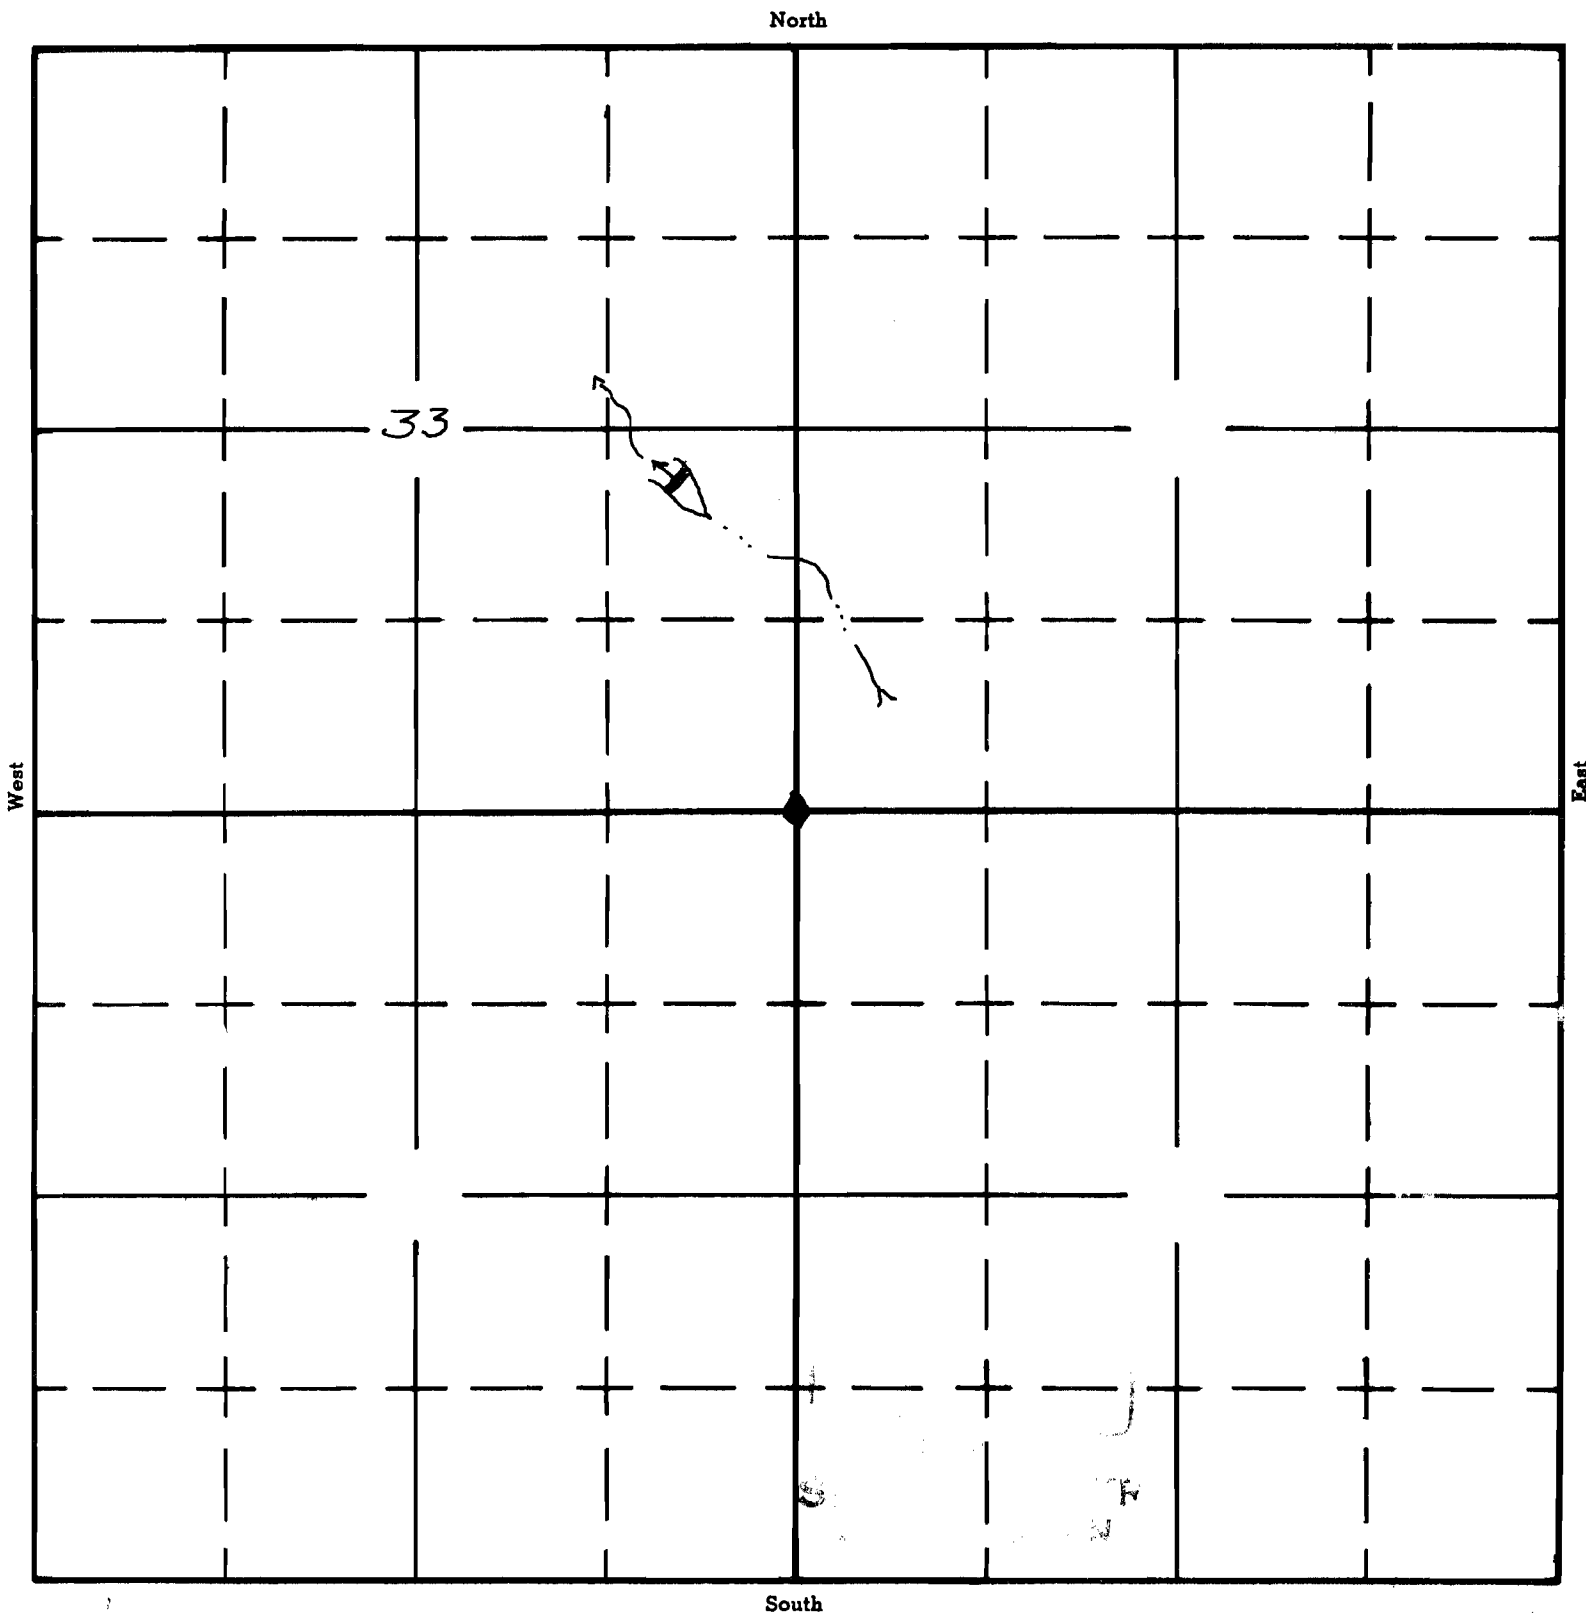

APPLICATION No. R-35356

PERMIT No. R-3109