

Form AI-187
March 1961


UNITED STATES
DEPARTMENT OF THE INTERIOR
BUREAU OF LAND MANAGEMENT

SECTION
NW 1/4 SW 1/4

SEC. 16

Oregon State Water Filings

TOWNSHIP 30 S, RANGE 34 E, W. M.

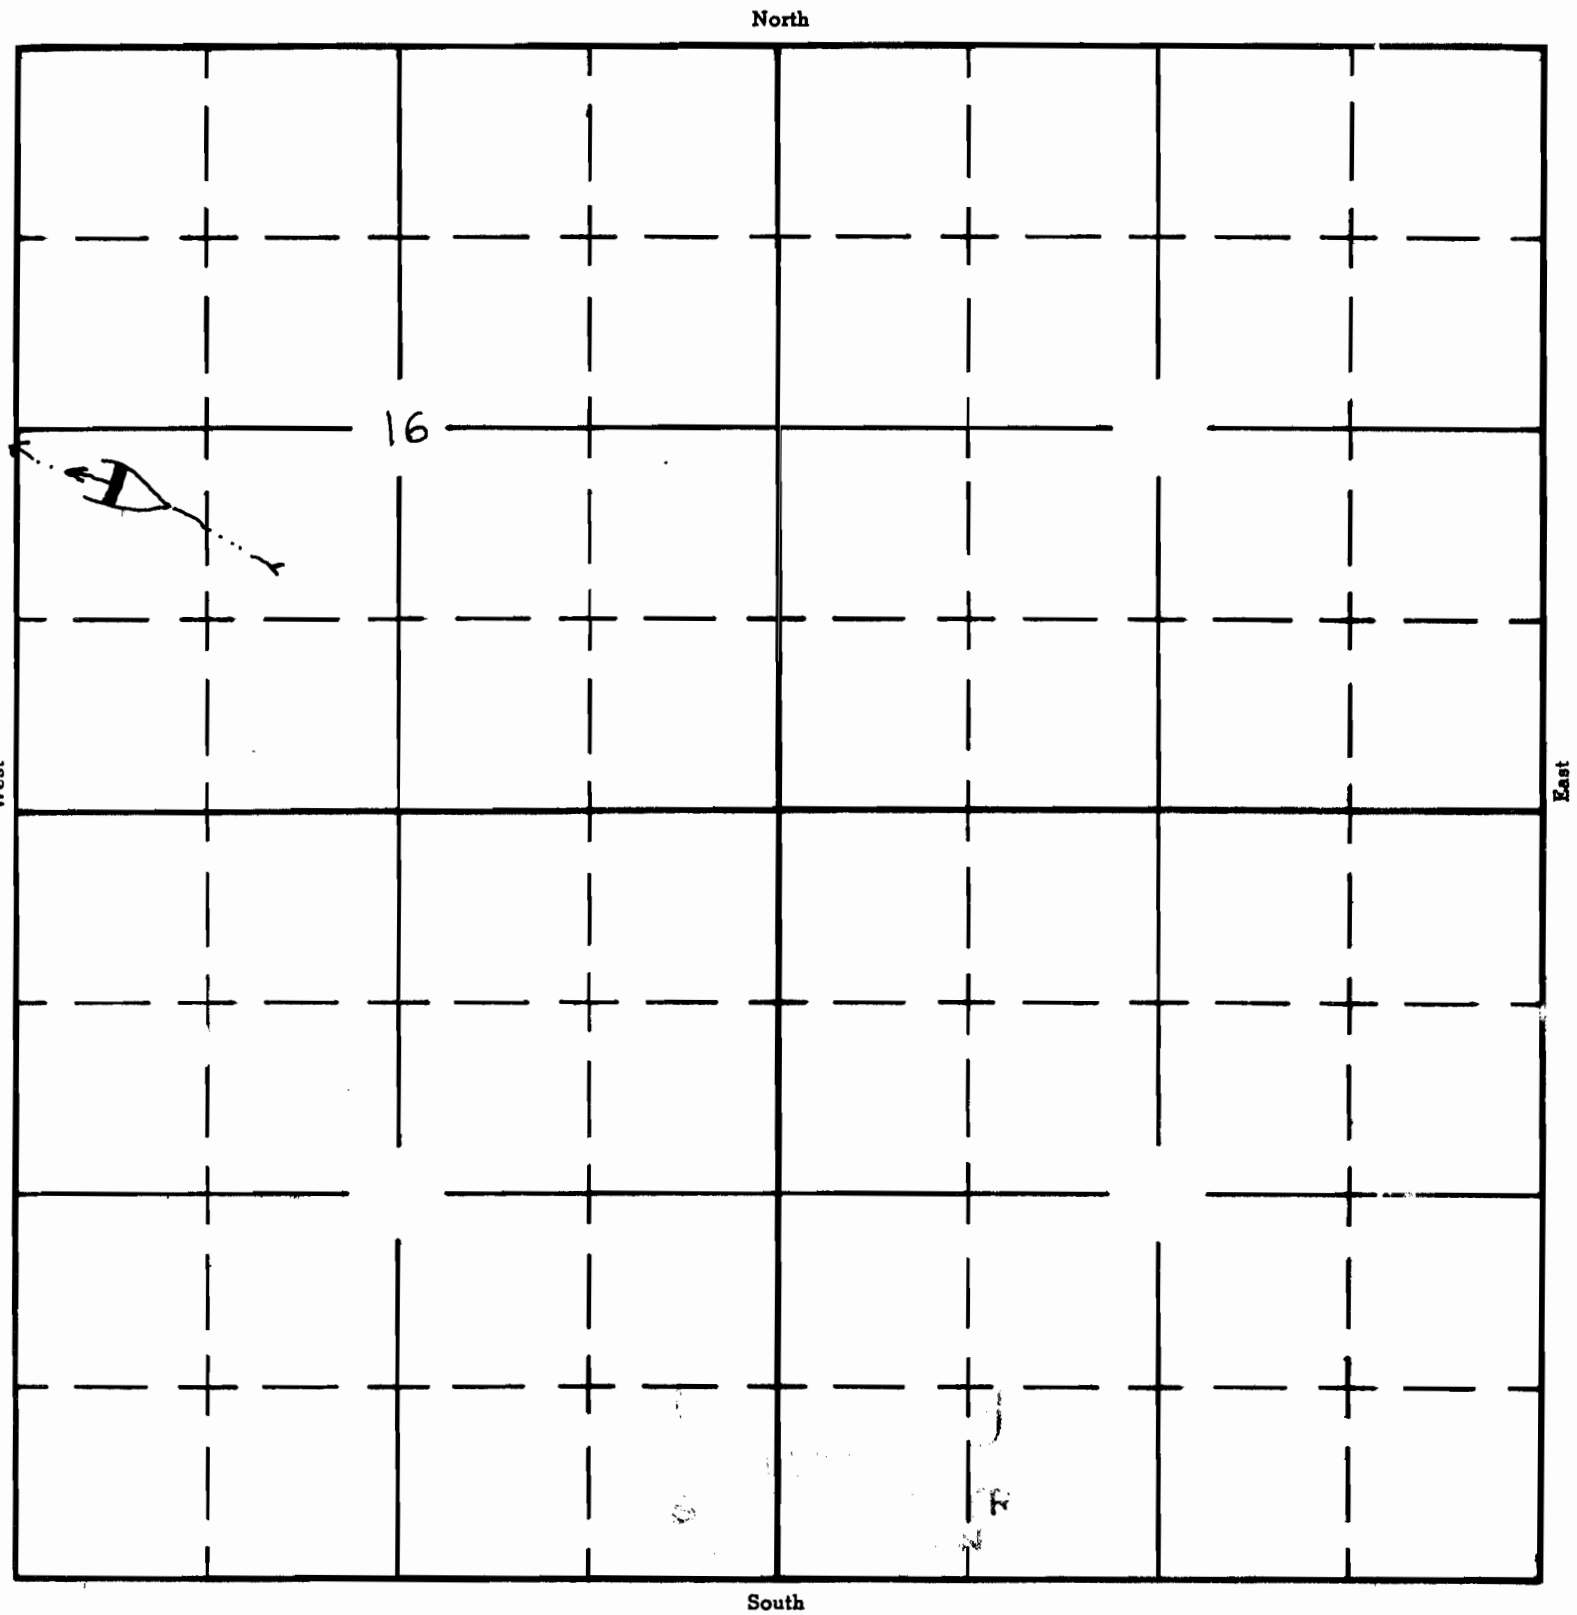

APPLICATION No. R-35357

PERMIT No. R-3110