

UNITED STATES
DEPARTMENT OF THE INTERIOR
BUREAU OF LAND MANAGEMENT

SECTION


SE 1/4 SW 1/4

Oregon State Water Filings

28

TOWNSHIP 21S, RANGE 31E, W. M.

North

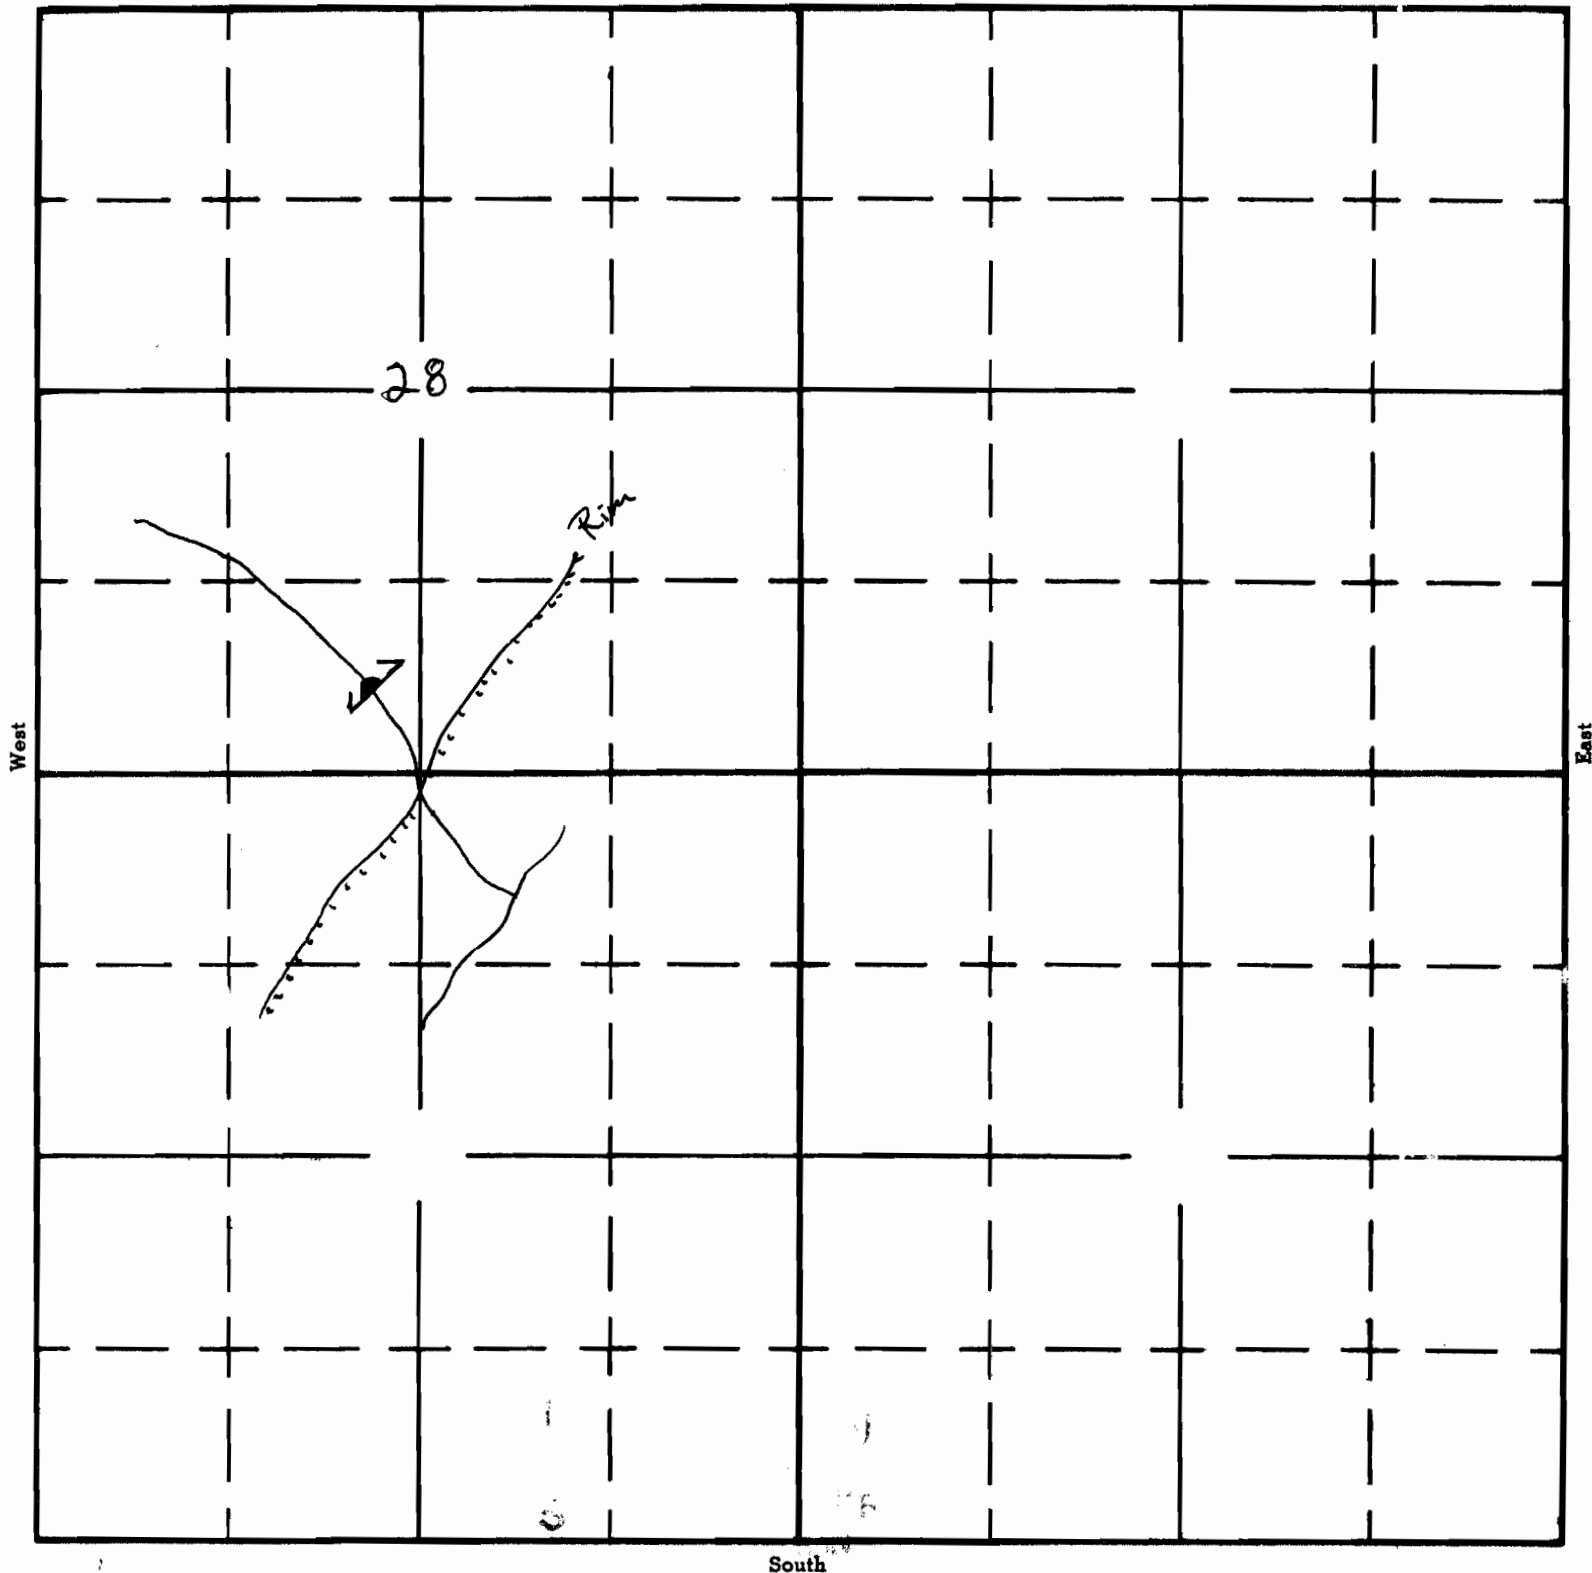

South

APPLICATION No. R-35377

PERMIT No. R-3120