

UNITED STATES
DEPARTMENT OF THE INTERIOR
BUREAU OF LAND MANAGEMENT


SECTION
NE $\frac{1}{4}$ NW $\frac{1}{4}$

Oregon State Water Filings

SEC. 14

TOWNSHIP 22 S, RANGE 29 E, W. M.

North

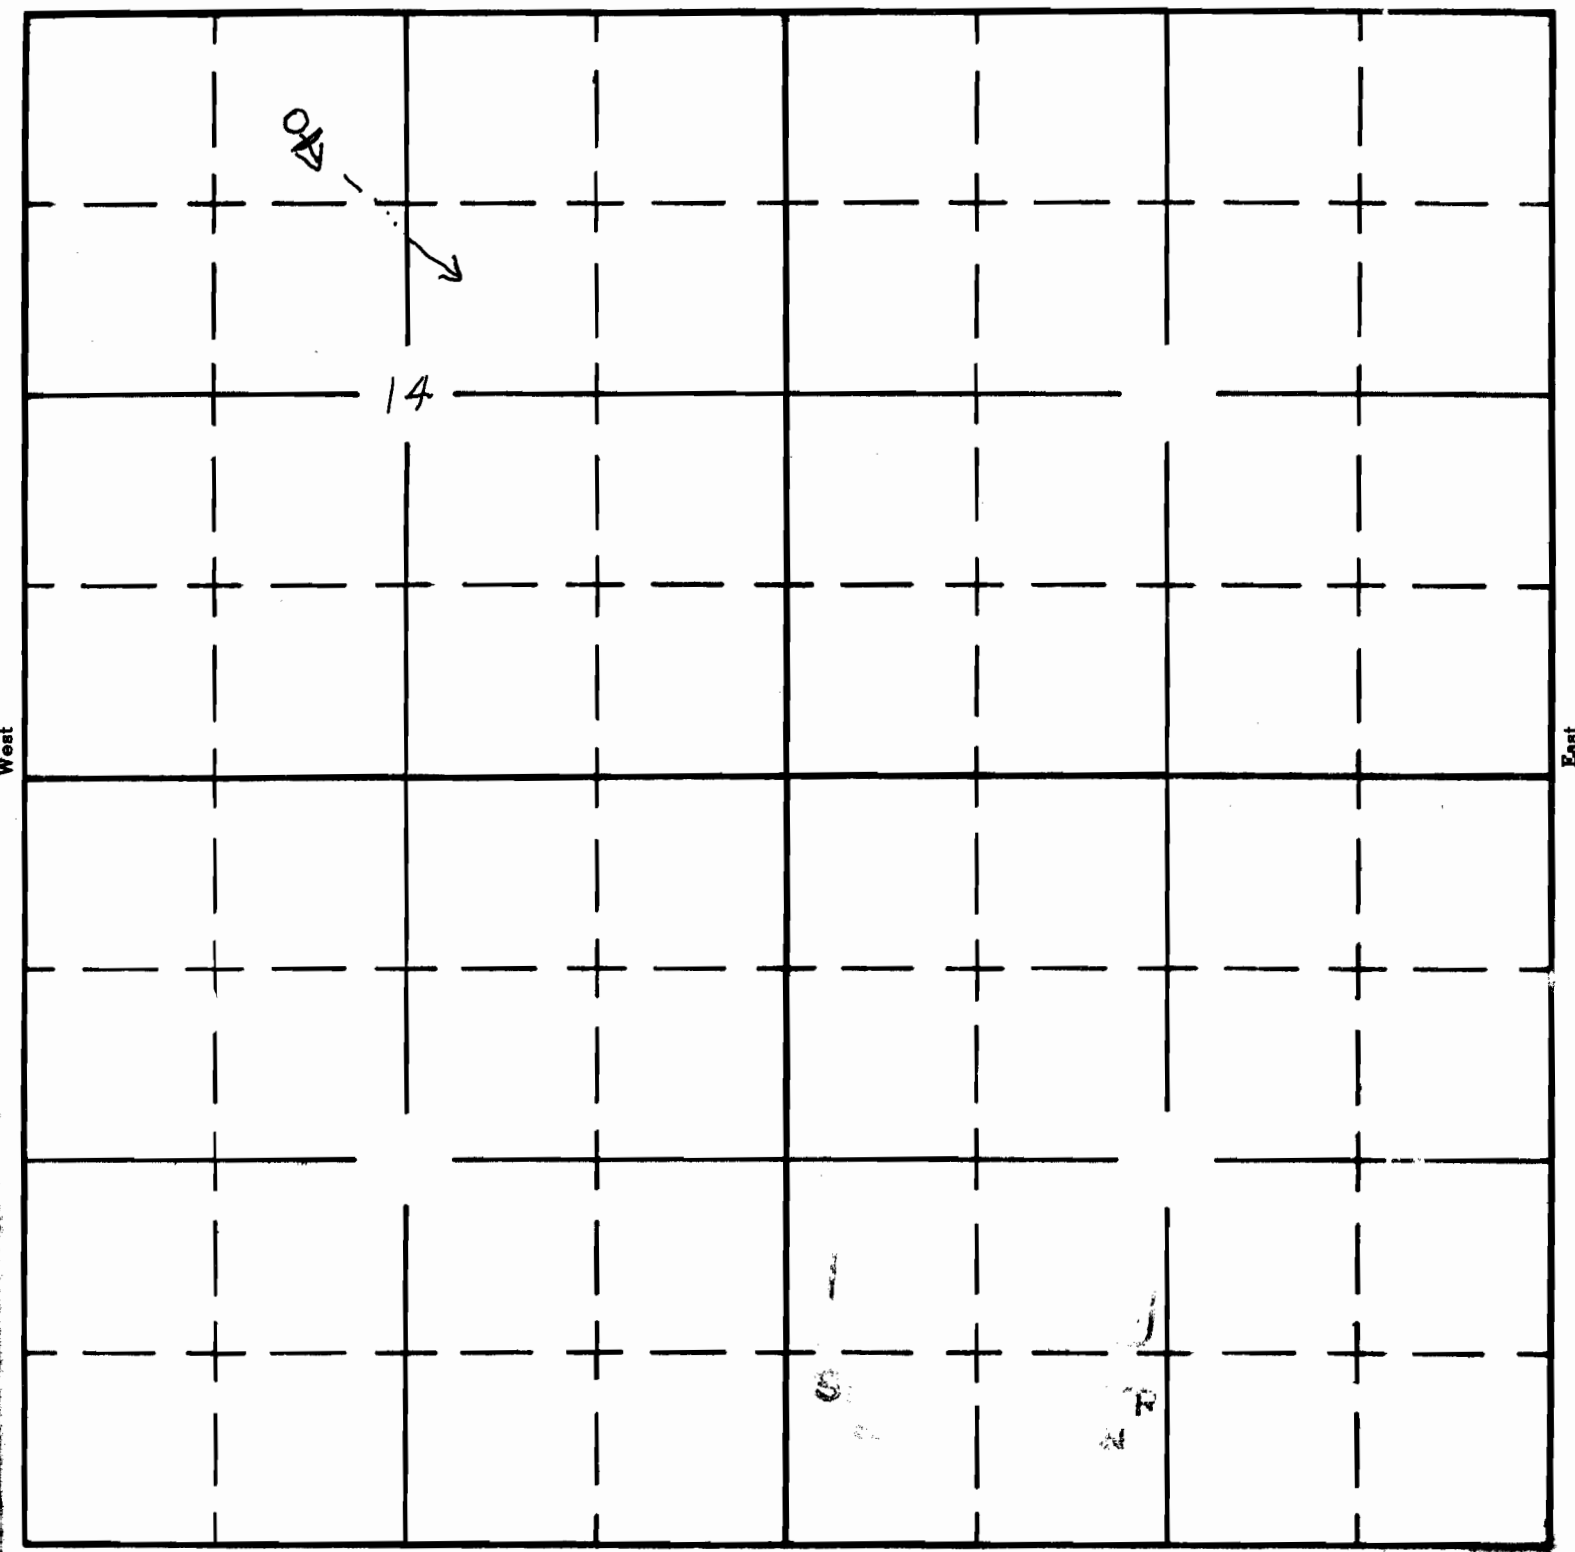

South

APPLICATION No. R-35382

PERMIT No. R-3125