
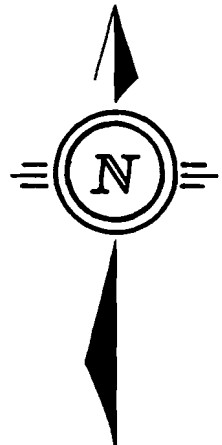


T. 13 S., R. 12 E. W.M.

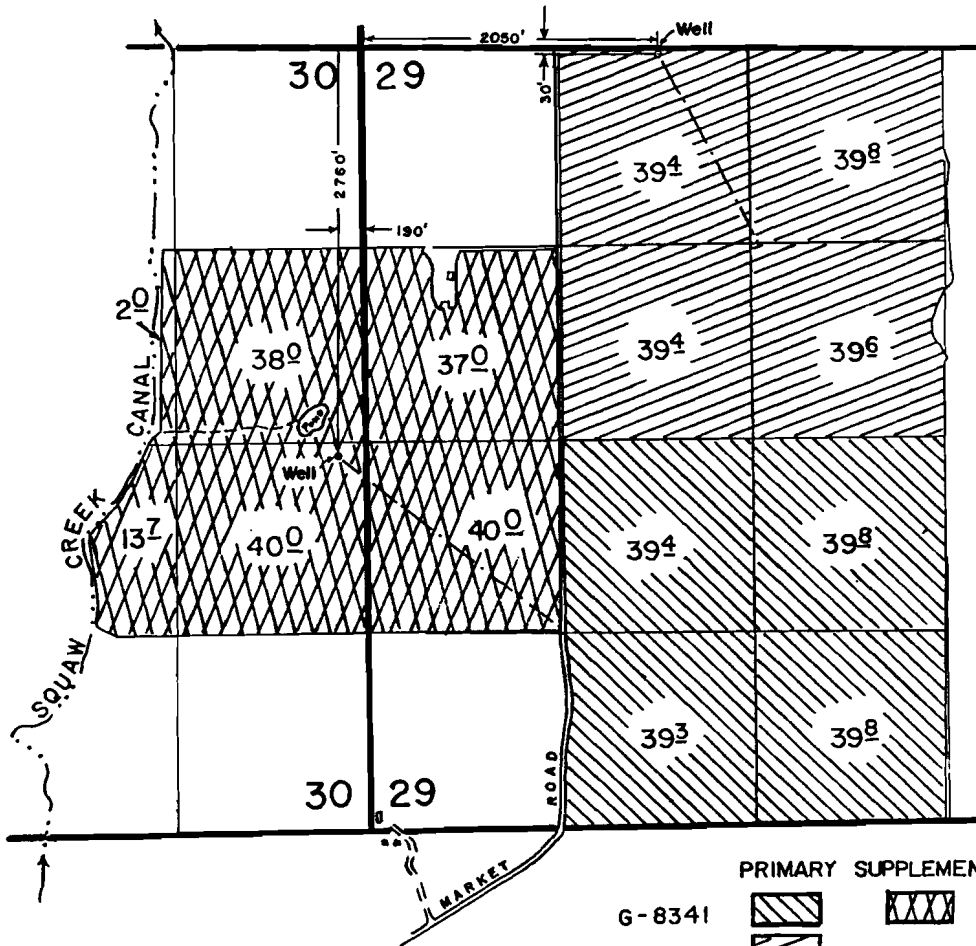

PRIMARY SUPPLEMENTAL
 G-8341 [diagonal lines] [cross-hatch]
 G-9688 [diagonal lines] [diagonal lines]
 (STONE) ↗

SCALE: 1" = 1,320'

FINAL PROOF SURVEY UNDER

G-8763 G-8341
 Application No. G-10453 Permit No. G-9688...
 IN NAME OF

BENJAMIN E. DAVIS and RICHARD J. & LEE L. STONE

Surveyed Sept. 16 1987, by M. MATTICK....

78832
 79405