

UNITED STATES
DEPARTMENT OF THE INTERIOR
BUREAU OF LAND MANAGEMENT


SECTION

10

Oregon State Water Filings

TOWNSHIP 29s, RANGE 296e, W. M.

North

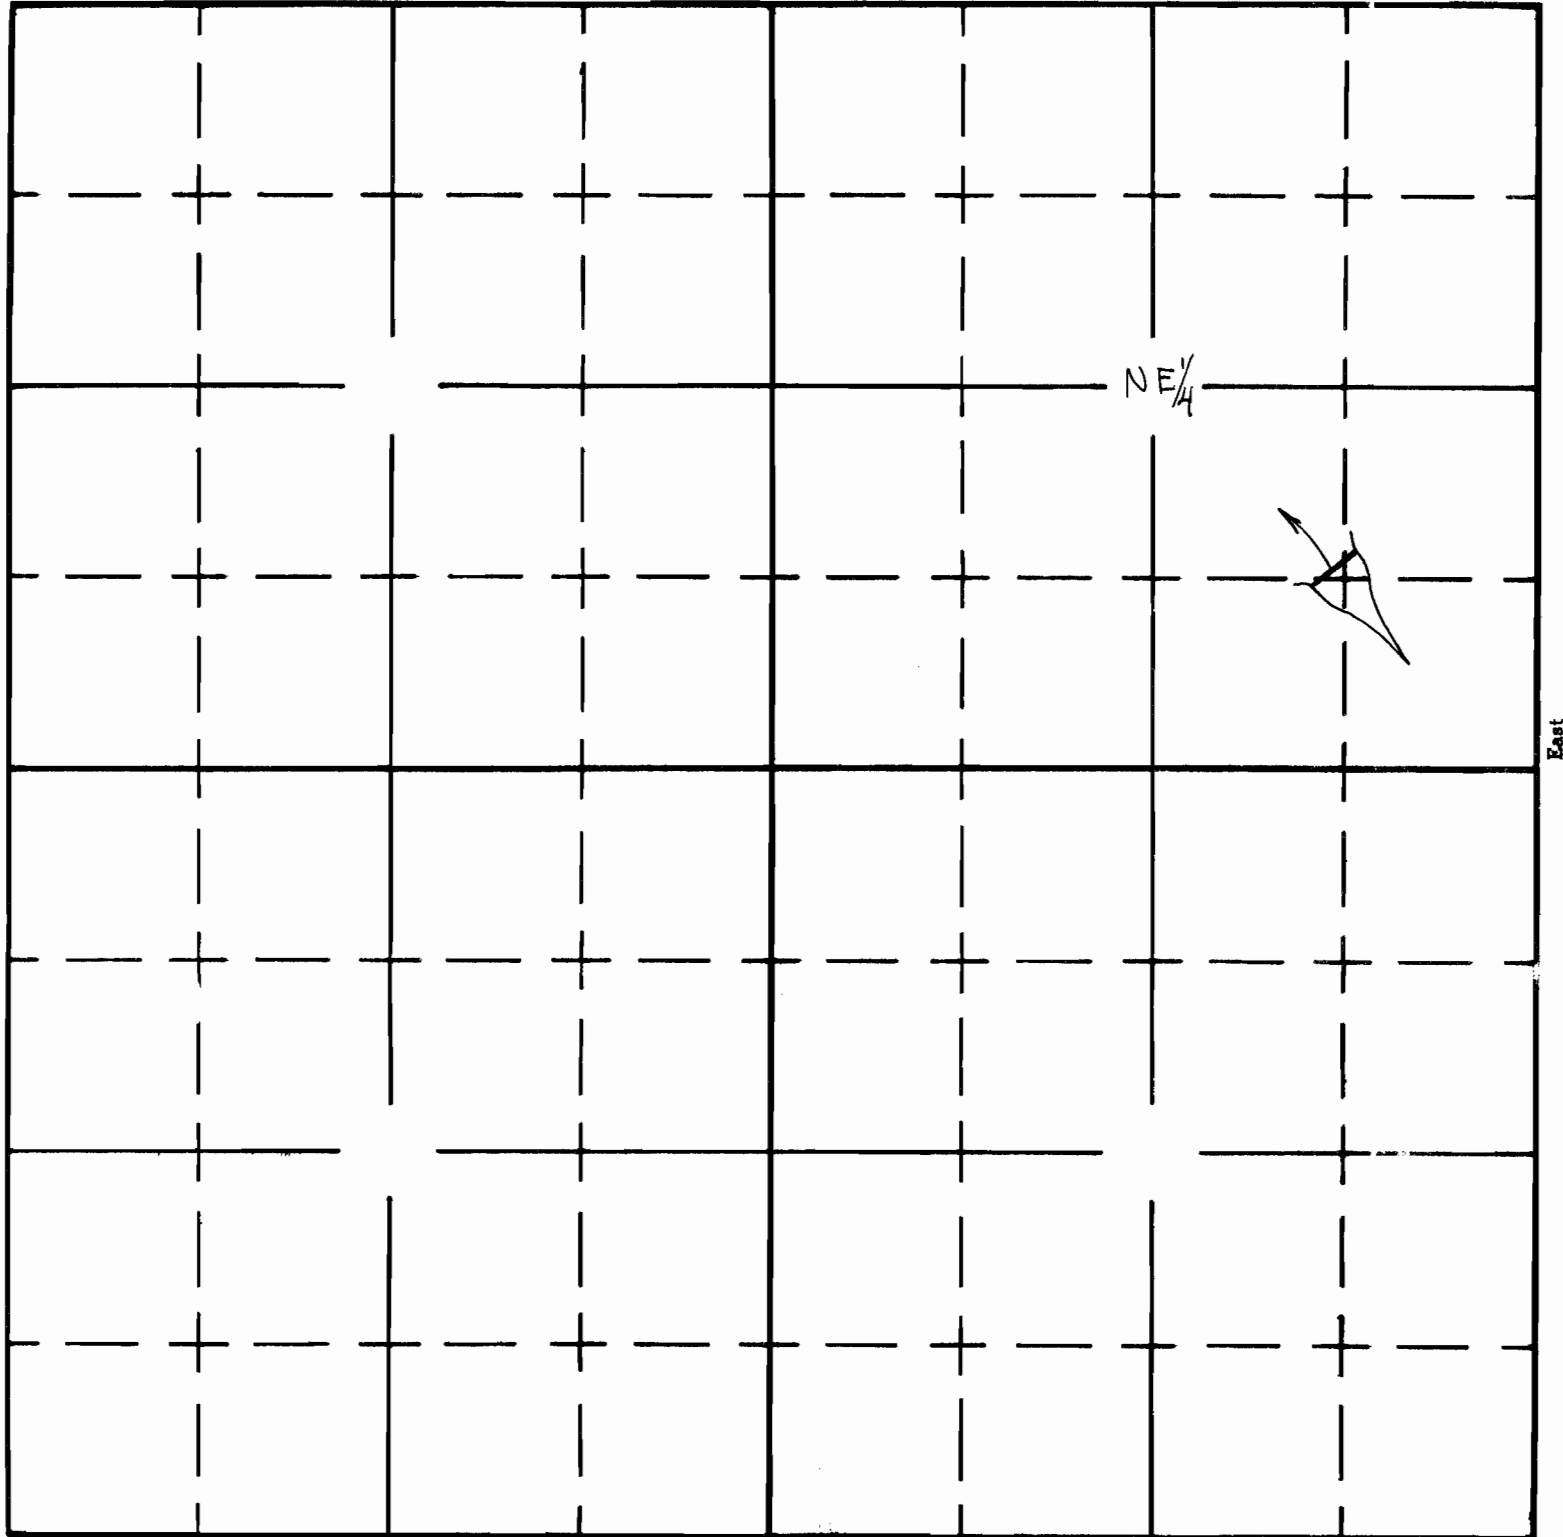

South

APPLICATION No. R-38278

PERMIT No. R-3186