

UNITED STATES
DEPARTMENT OF THE INTERIOR
BUREAU OF LAND MANAGEMENT


SECTION

5

Oregon State Water Filings

TOWNSHIP 29S, RANGE 29E, W. M.

North

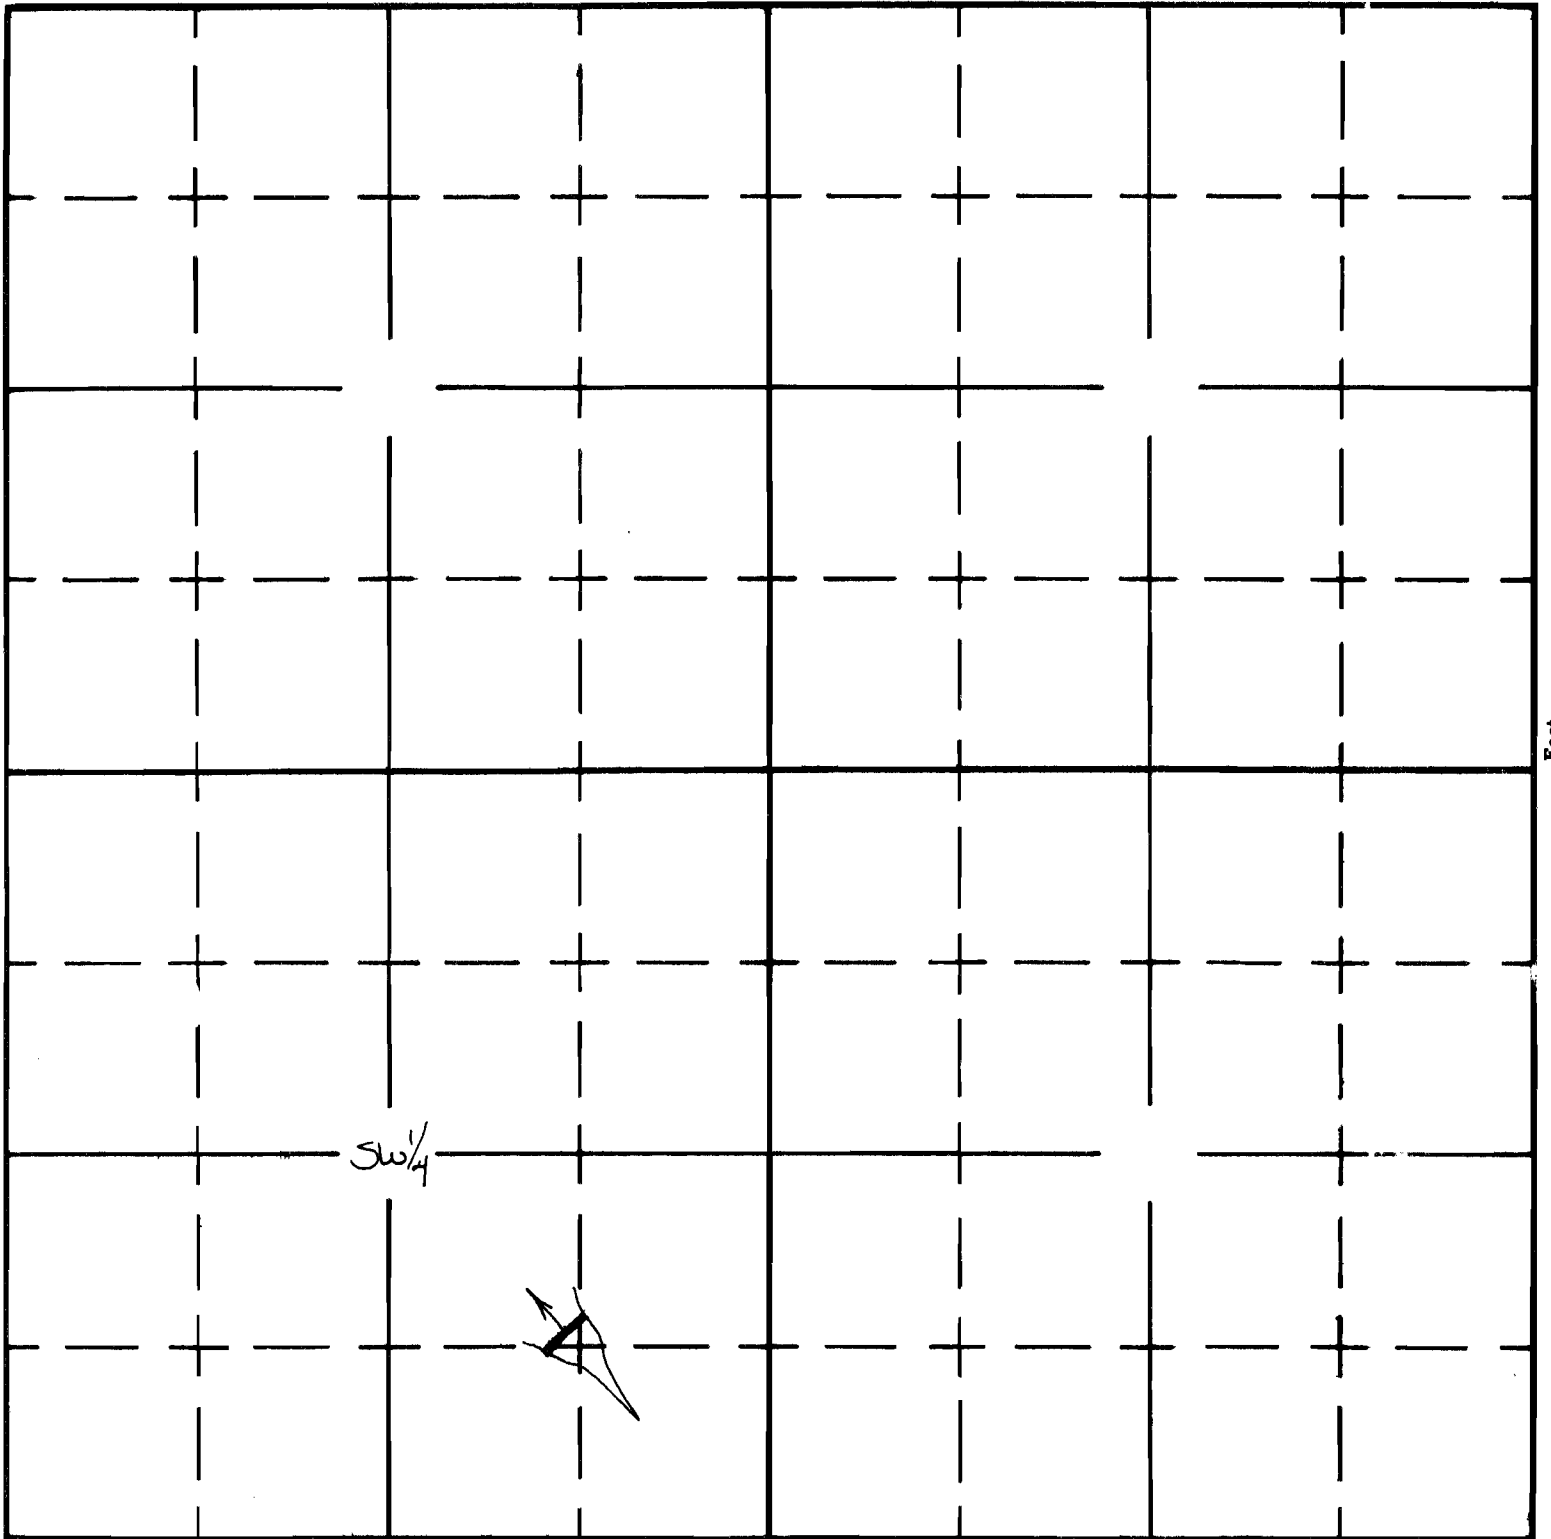

South

APPLICATION No. R-38304
PERMIT No. R-3192