

UNITED STATES
DEPARTMENT OF THE INTERIOR
BUREAU OF LAND MANAGEMENT

SECTION


NW 1/4 SW 1/4

Oregon State Water Filings

8

TOWNSHIP 21S, RANGE 30E, W. M.

North

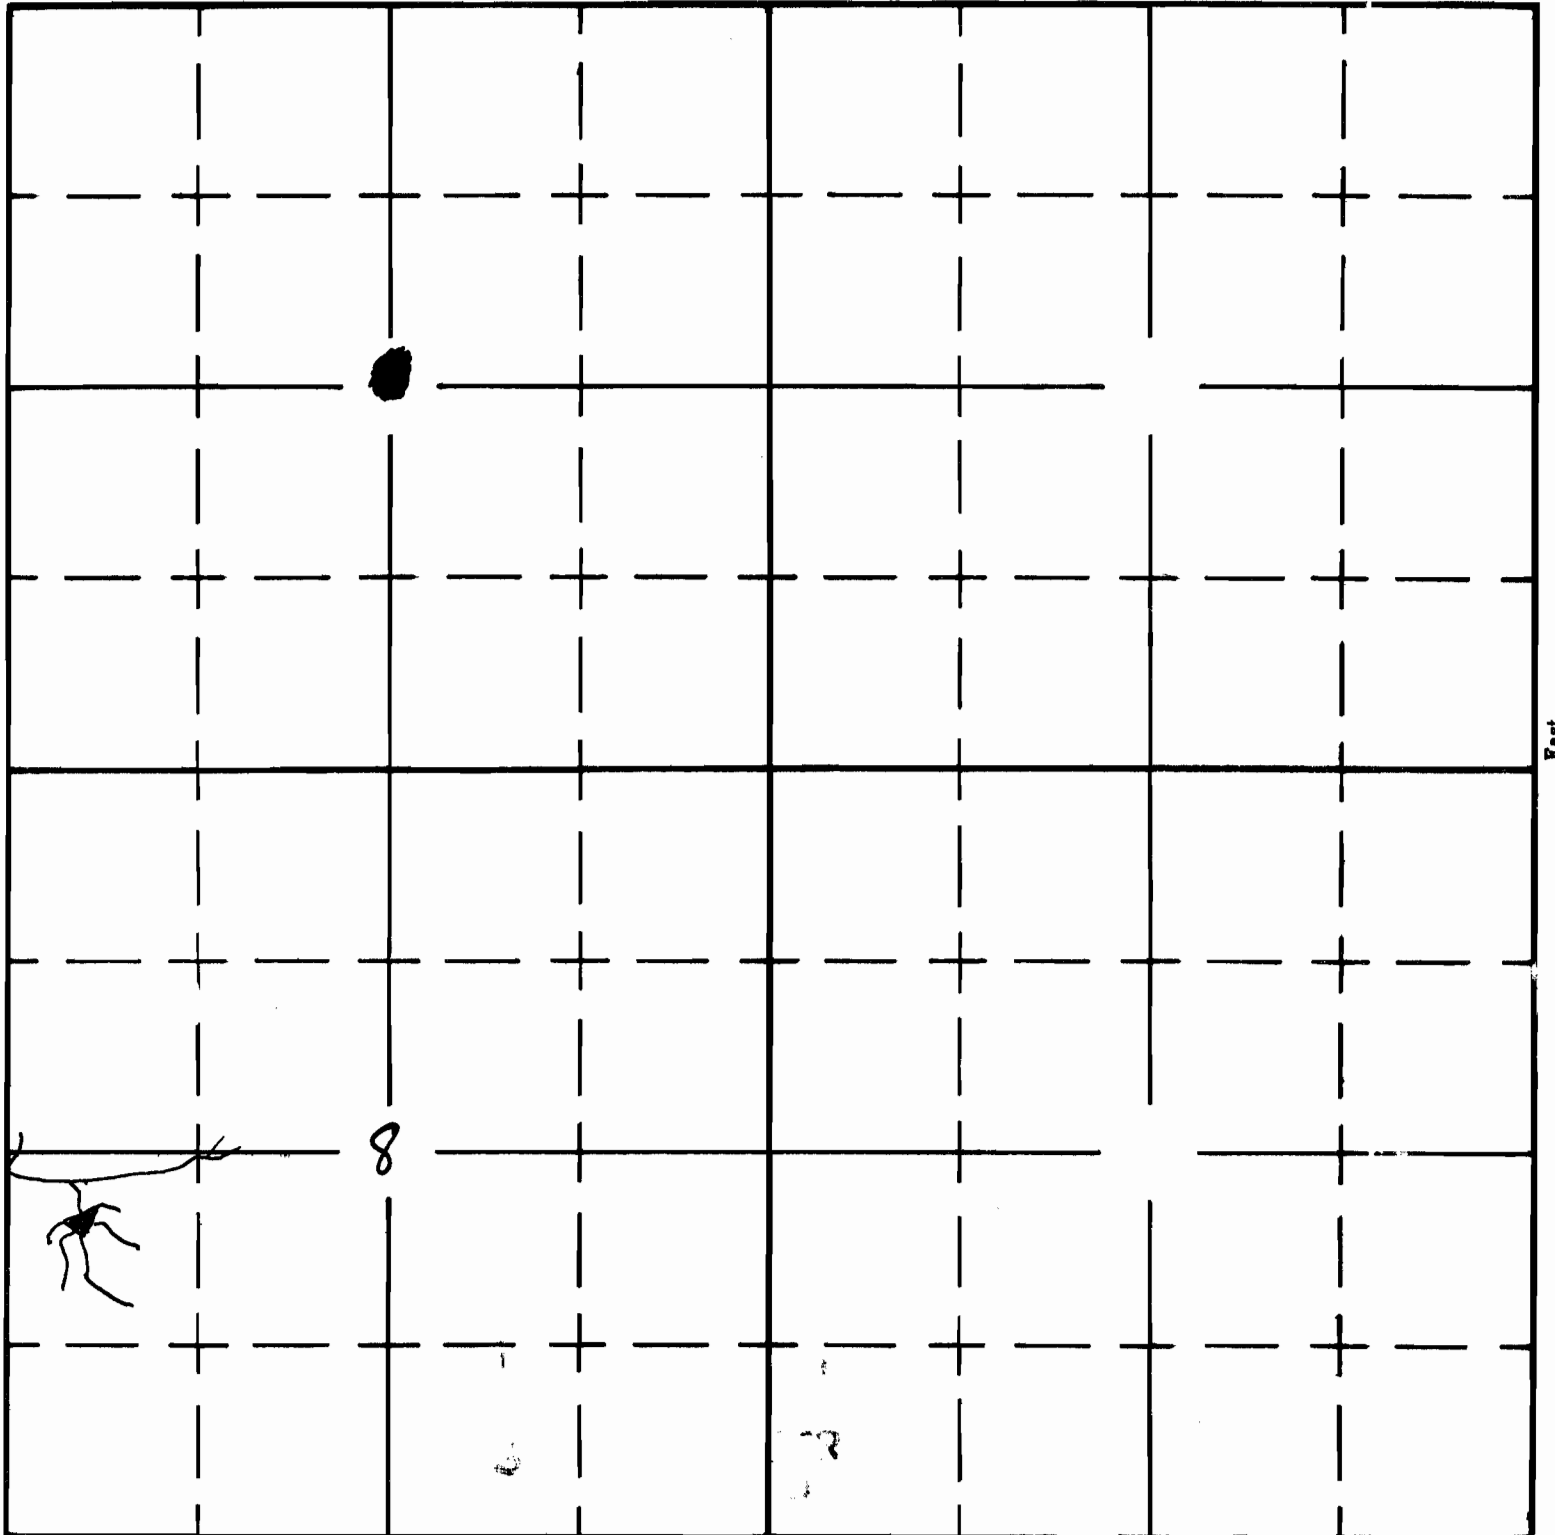

South

APPLICATION No. R-35419
PERMIT No. R-3307