

UNITED STATES
DEPARTMENT OF THE INTERIOR
BUREAU OF LAND MANAGEMENT

SECTION


NW 1/4 SW 1/4

Oregon State Water Filings

29

TOWNSHIP 21 S, RANGE 31 E, W. M.

North

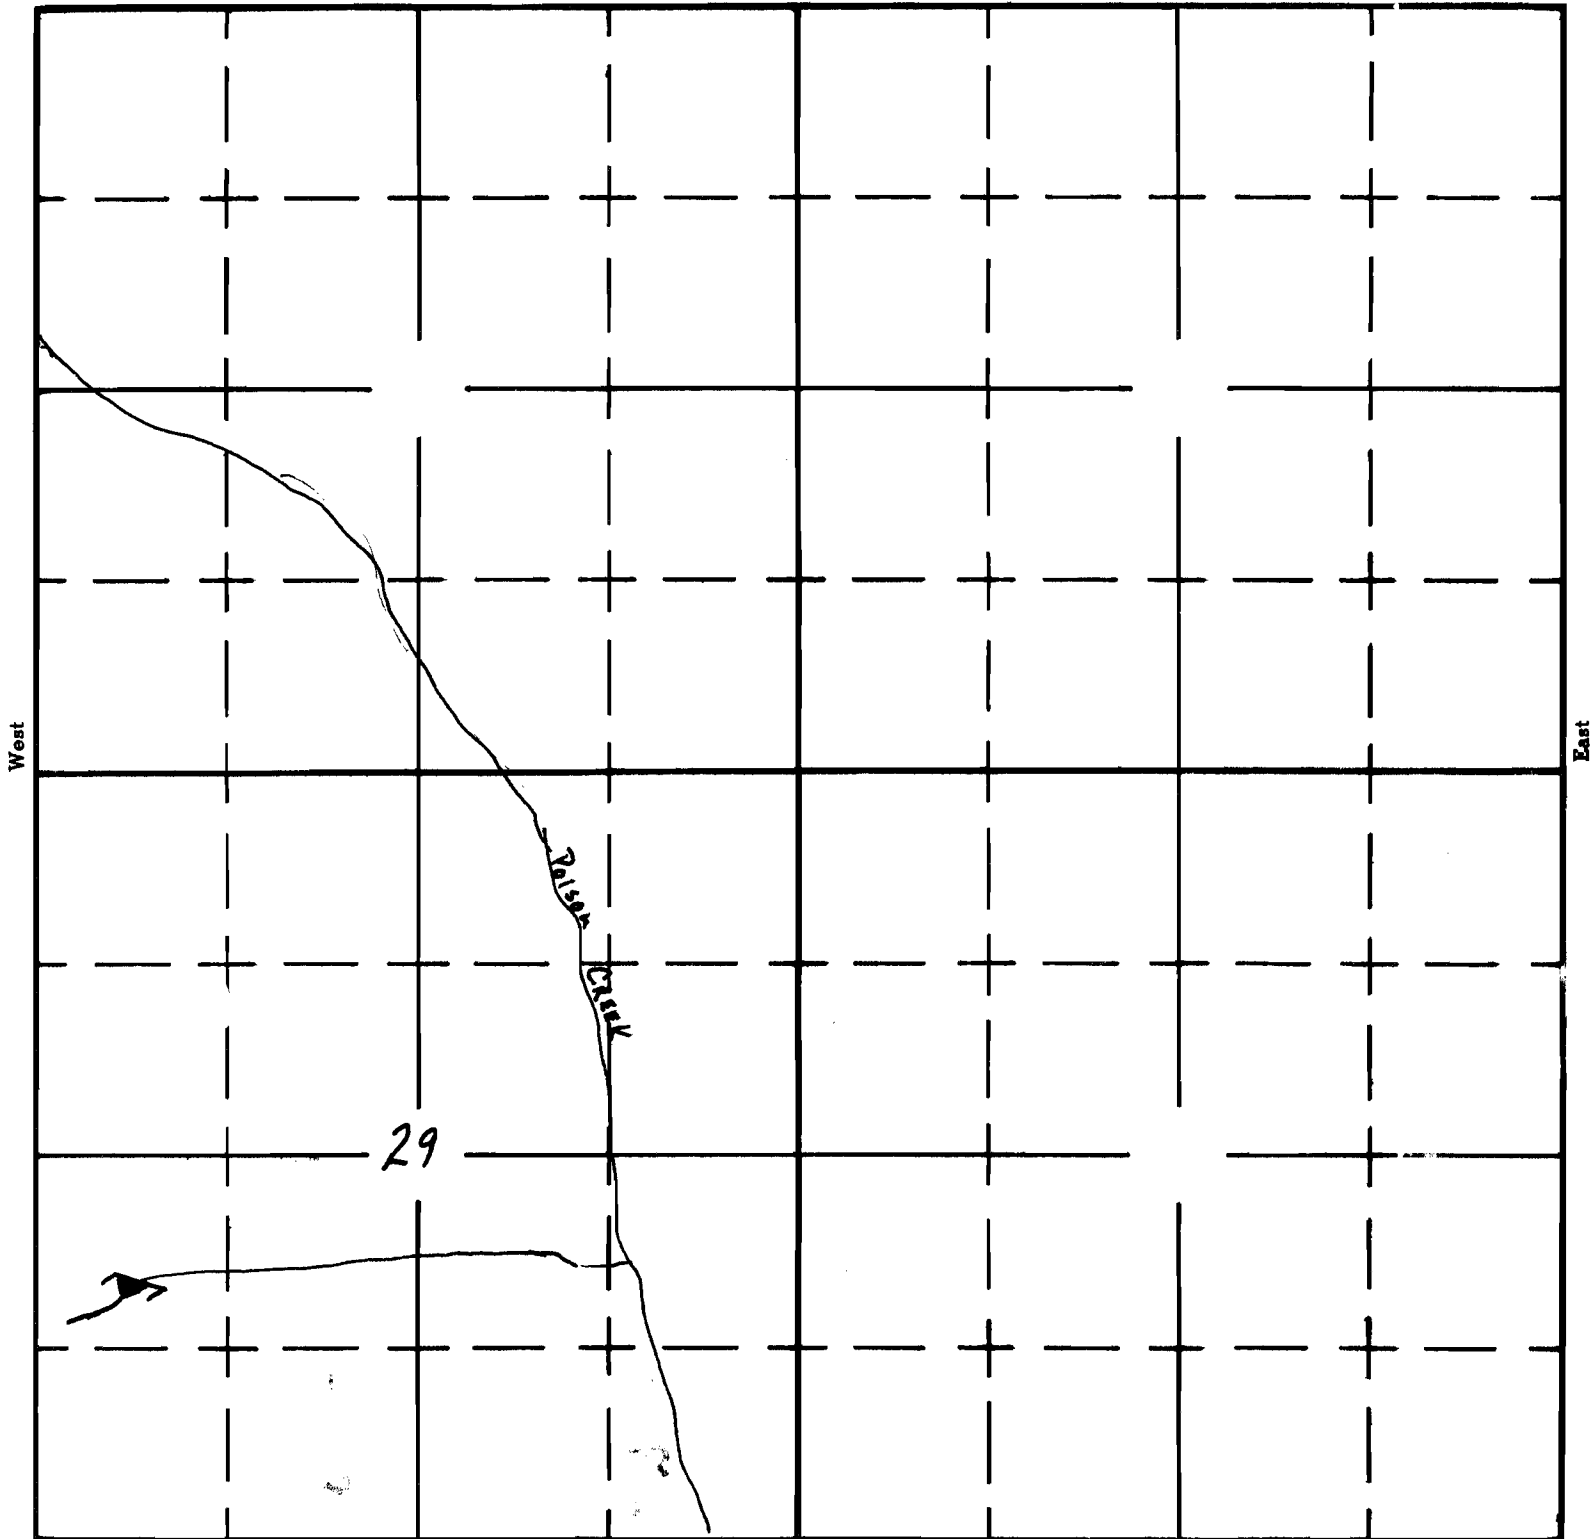

South

APPLICATION No. R-35420
PERMIT No. R-3308