

Form A1-187
March 1961

UNITED STATES
DEPARTMENT OF THE INTERIOR
BUREAU OF LAND MANAGEMENT

SECTION


SW¹/₄ SE¹/₄

Oregon State Water Filings

28

TOWNSHIP 23 S, RANGE 34 E, W. M.

North

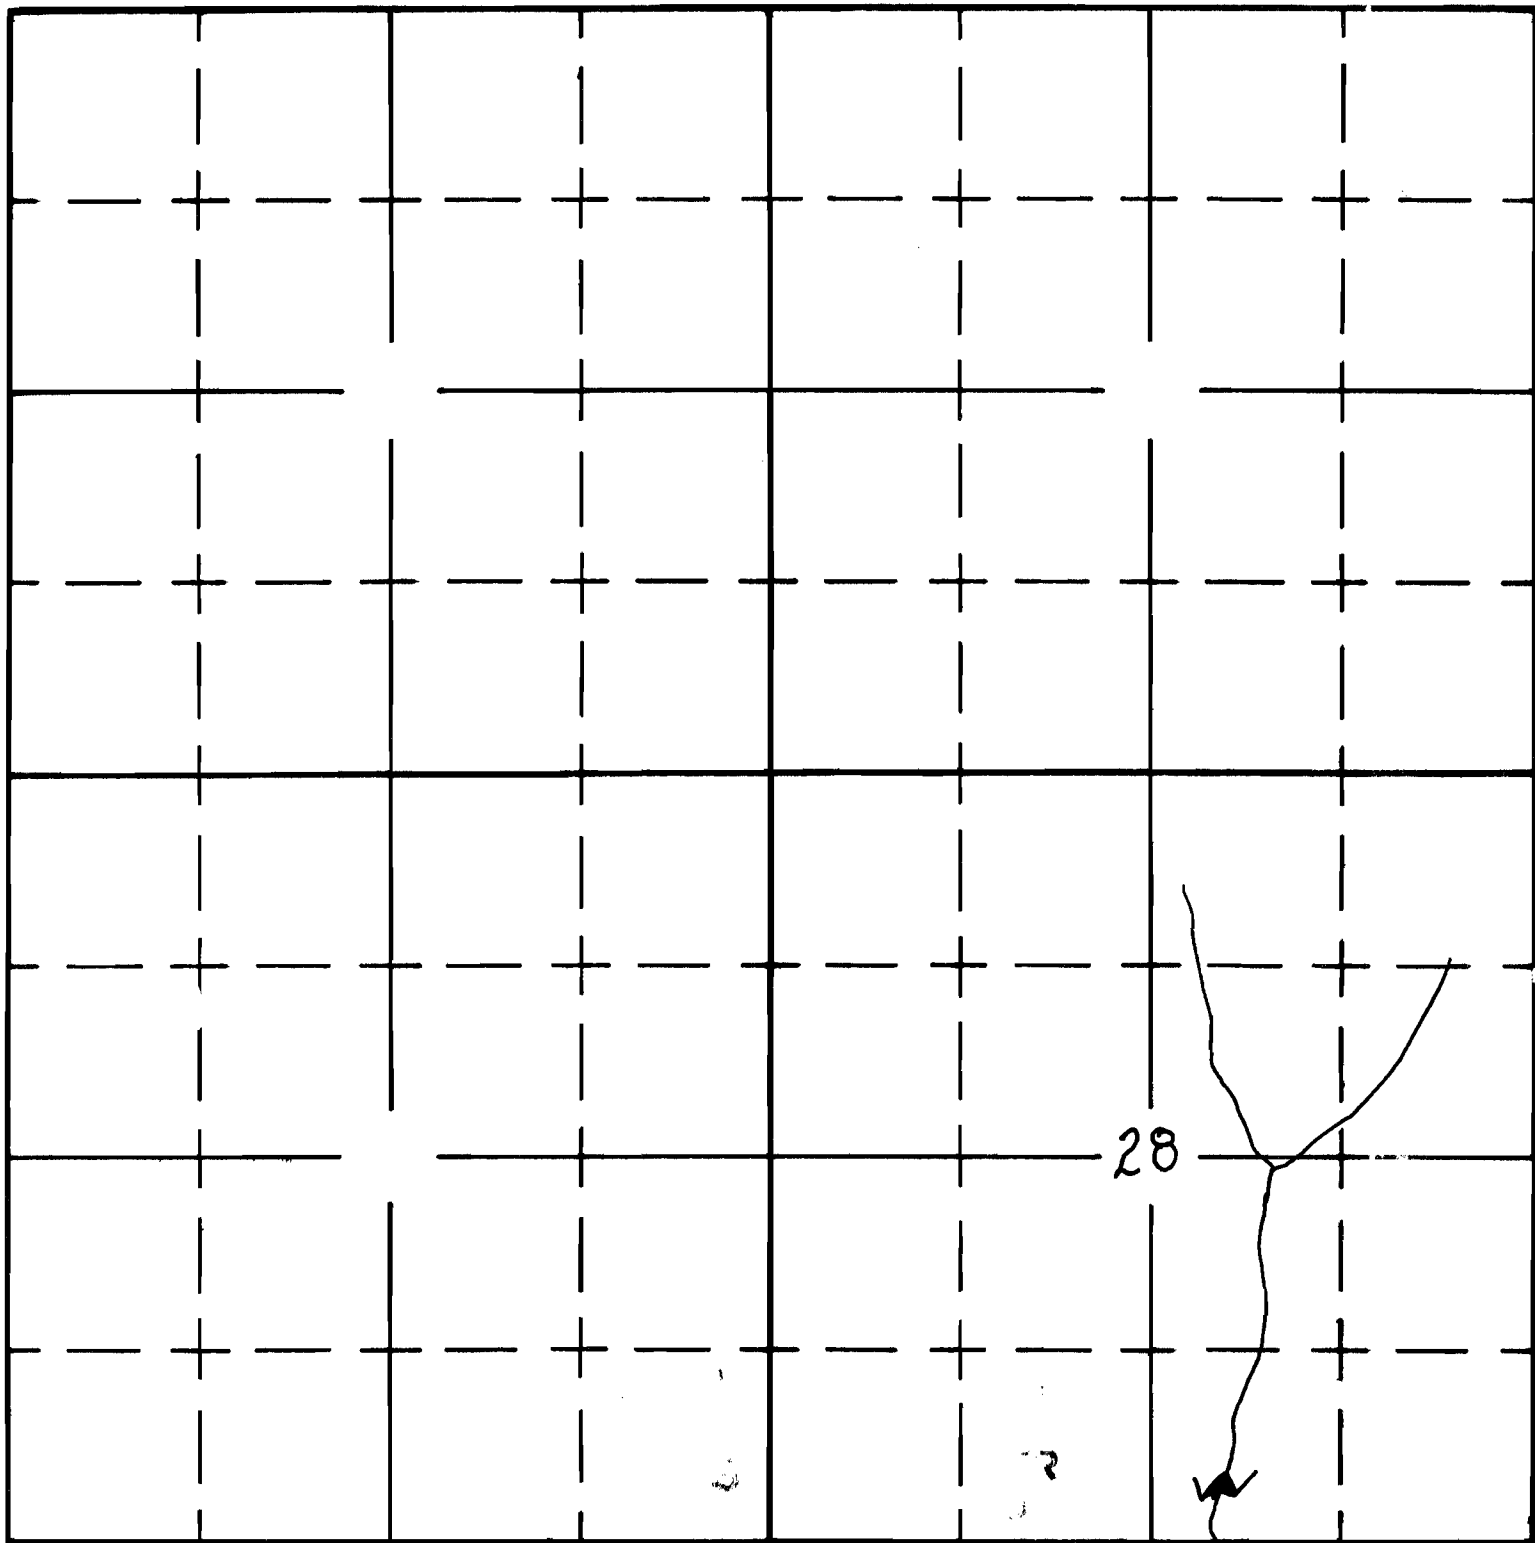

South

APPLICATION No. R-35423
PERMIT No. R-3311