

Form AI-187
March 1961

UNITED STATES
DEPARTMENT OF THE INTERIOR
BUREAU OF LAND MANAGEMENT

SECTION


NE 1/4 NE 1/4

Oregon State Water Filings

Sec 24

TOWNSHIP 21 S, RANGE 30 E, W. M.

North

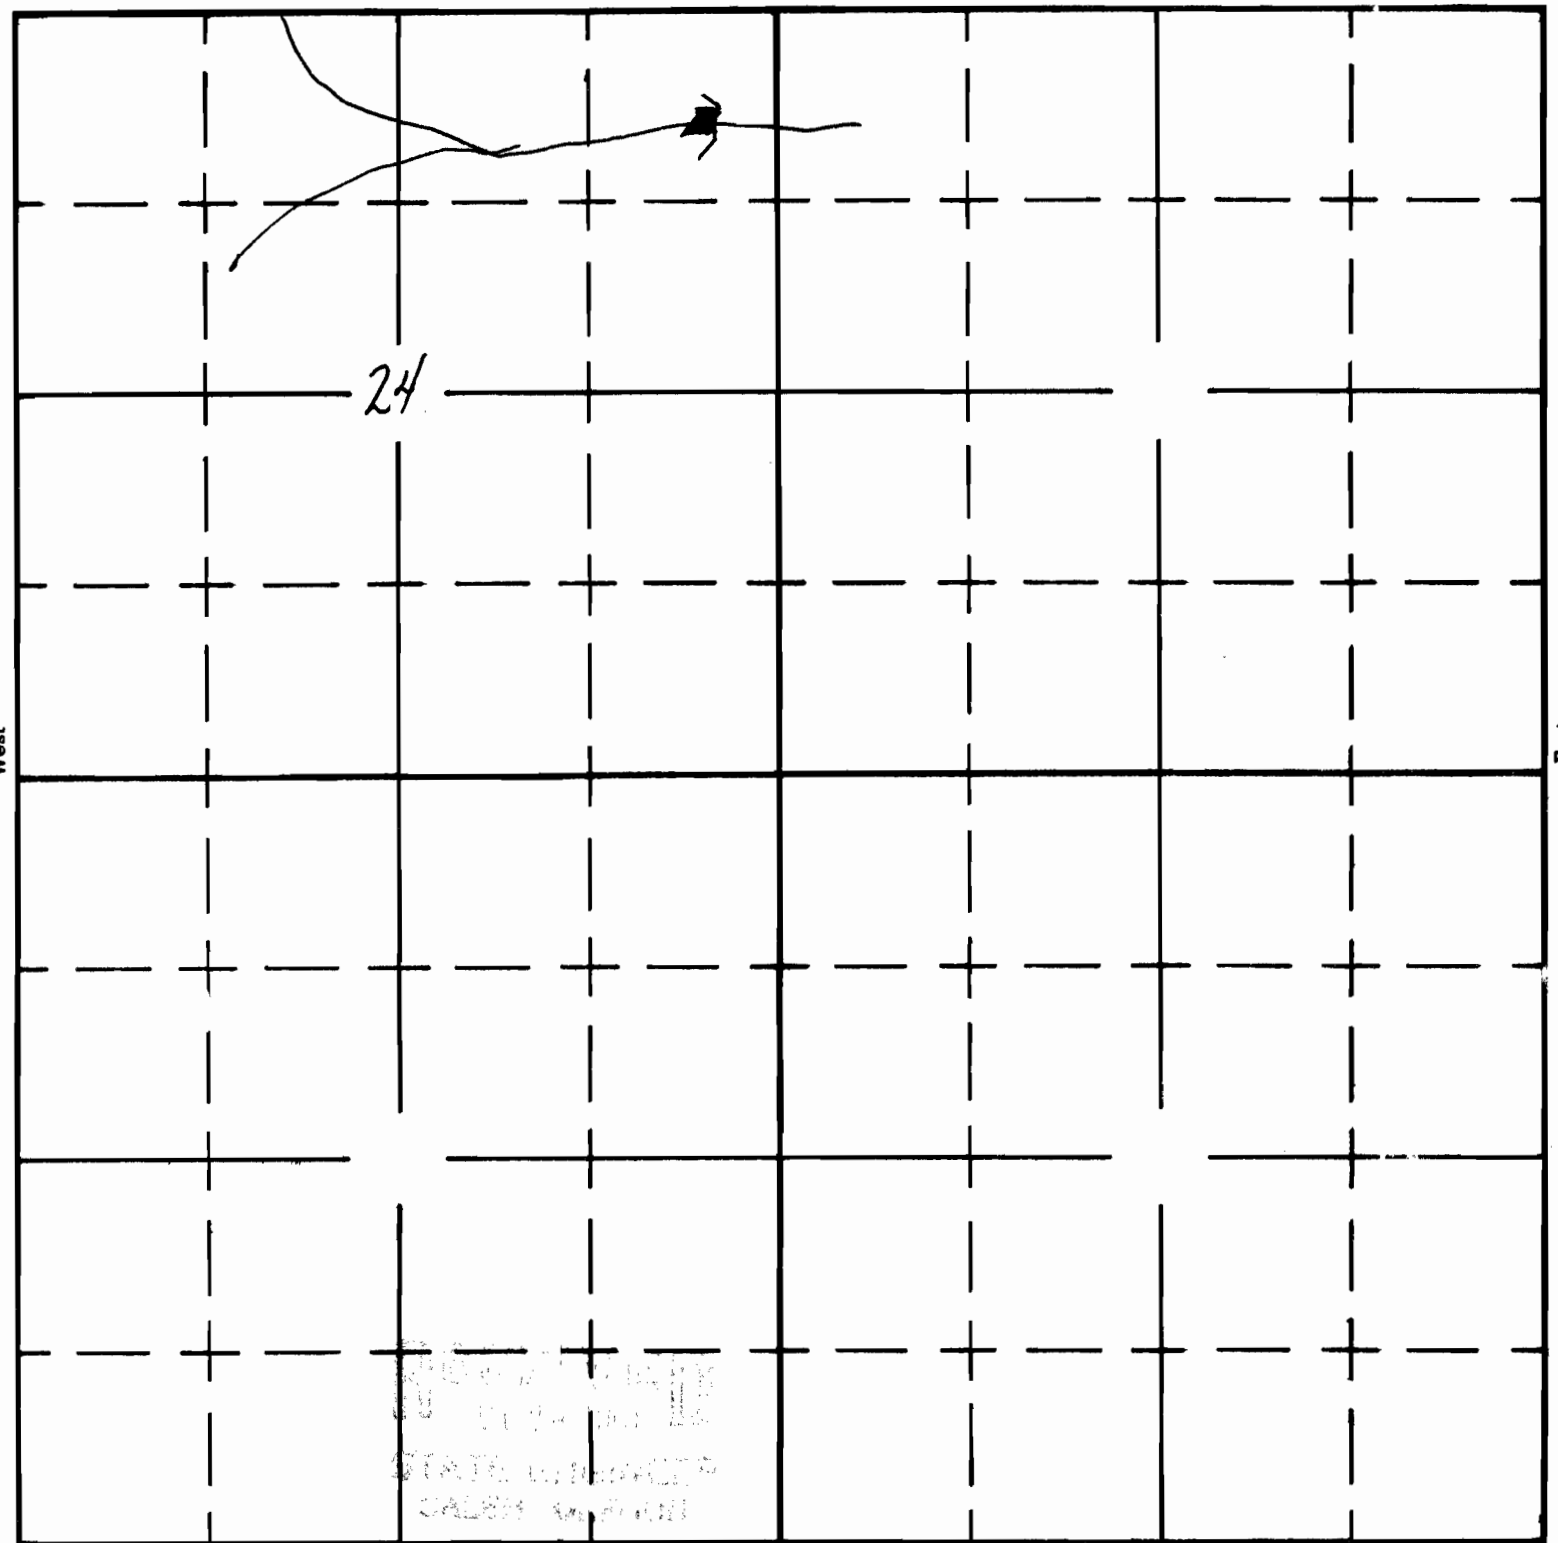

South

APPLICATION No. R-35450
PERMIT No. R-3315