


UNITED STATES
DEPARTMENT OF THE INTERIOR
BUREAU OF LAND MANAGEMENT

SECTION SW 1/4 SE 1/4 **Oregon State Water Filings**

12 TOWNSHIP 21 S, RANGE 29 E, W. M.

North

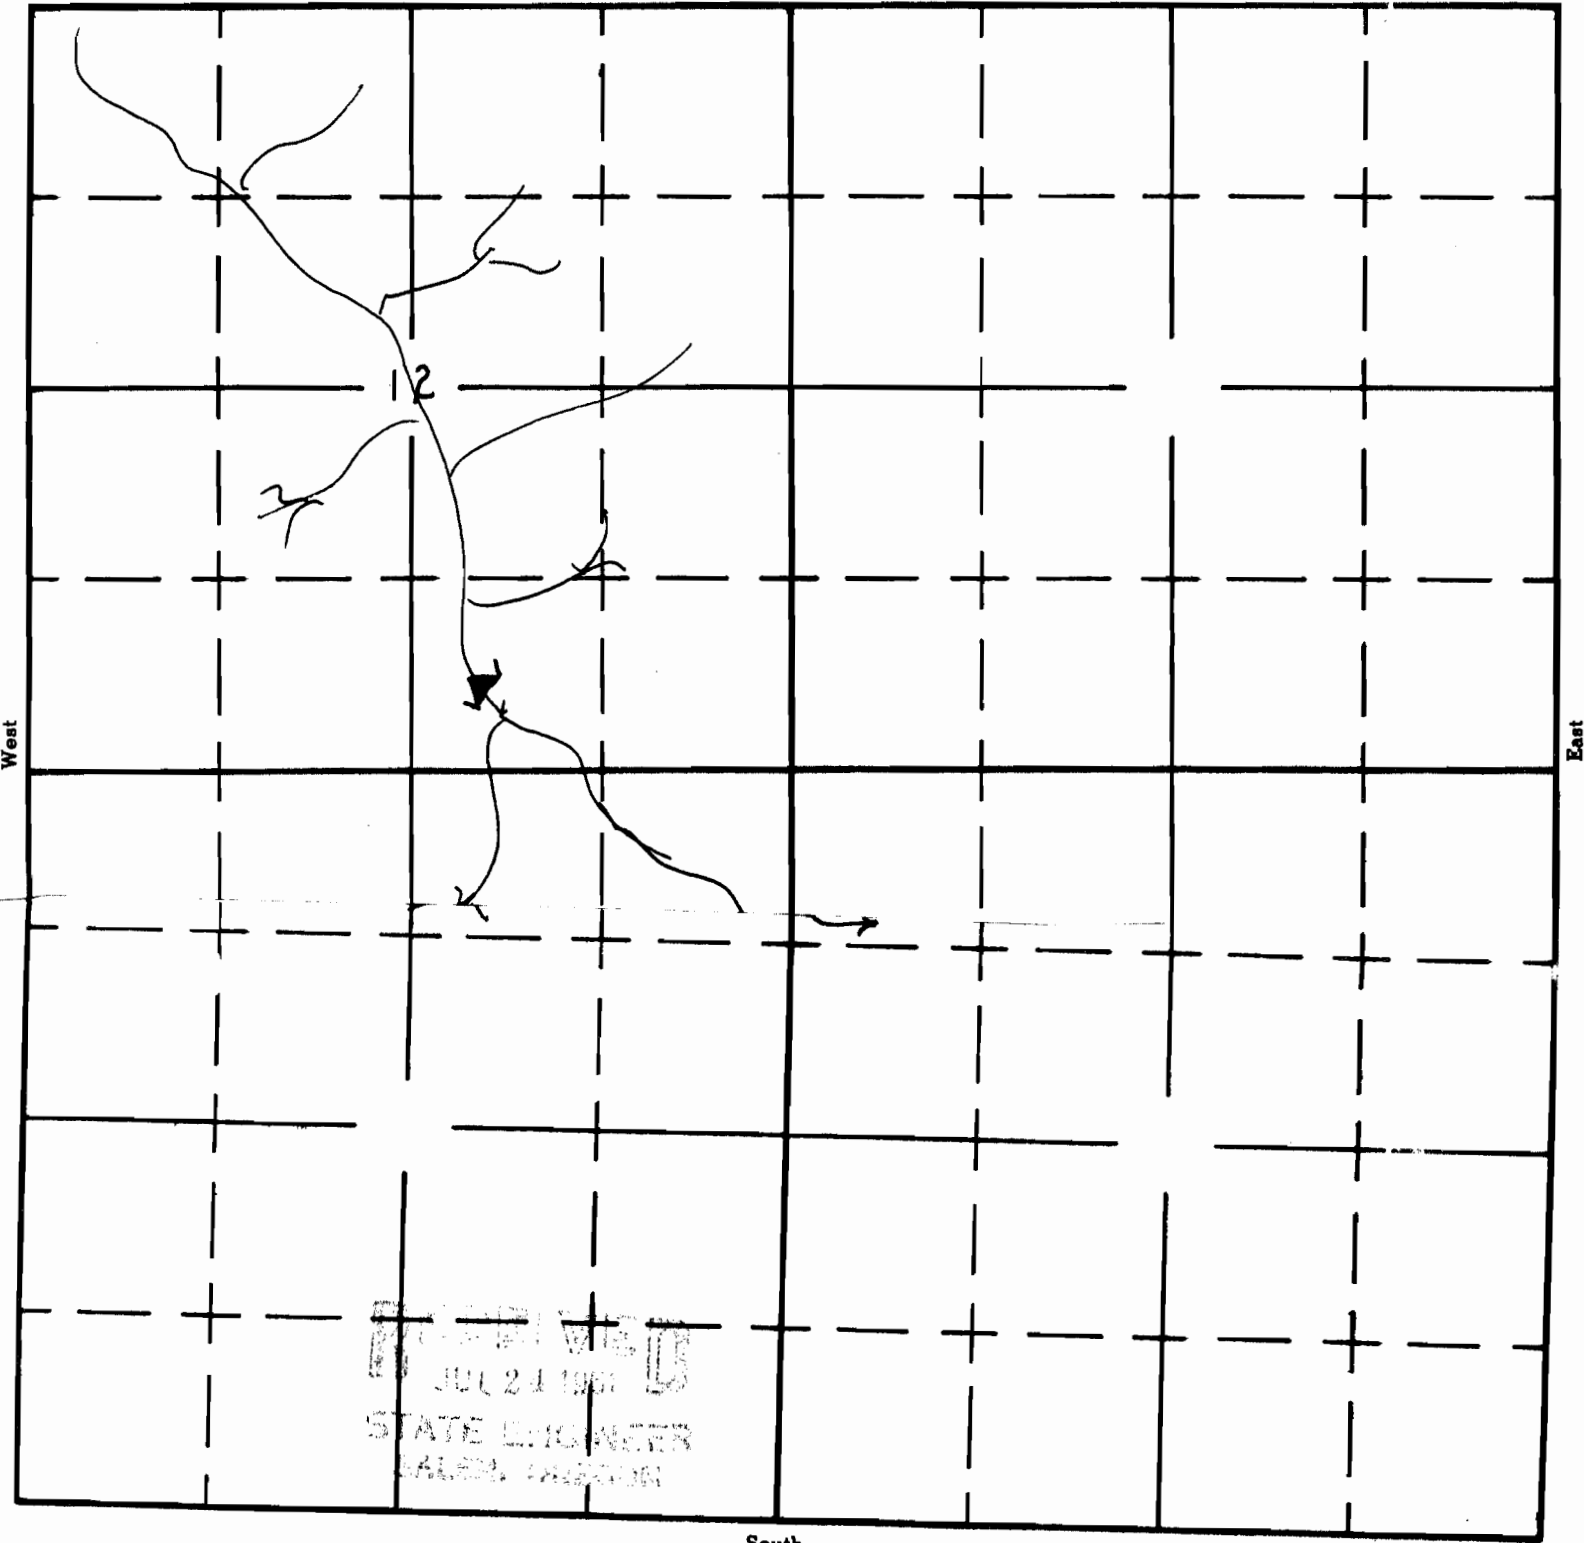

South