

UNITED STATES
DEPARTMENT OF THE INTERIOR
BUREAU OF LAND MANAGEMENT

SECTION


SE 1/4 NE 1/4

Oregon State Water Filings

17

TOWNSHIP 23 S, RANGE 29 E, W. M.

North

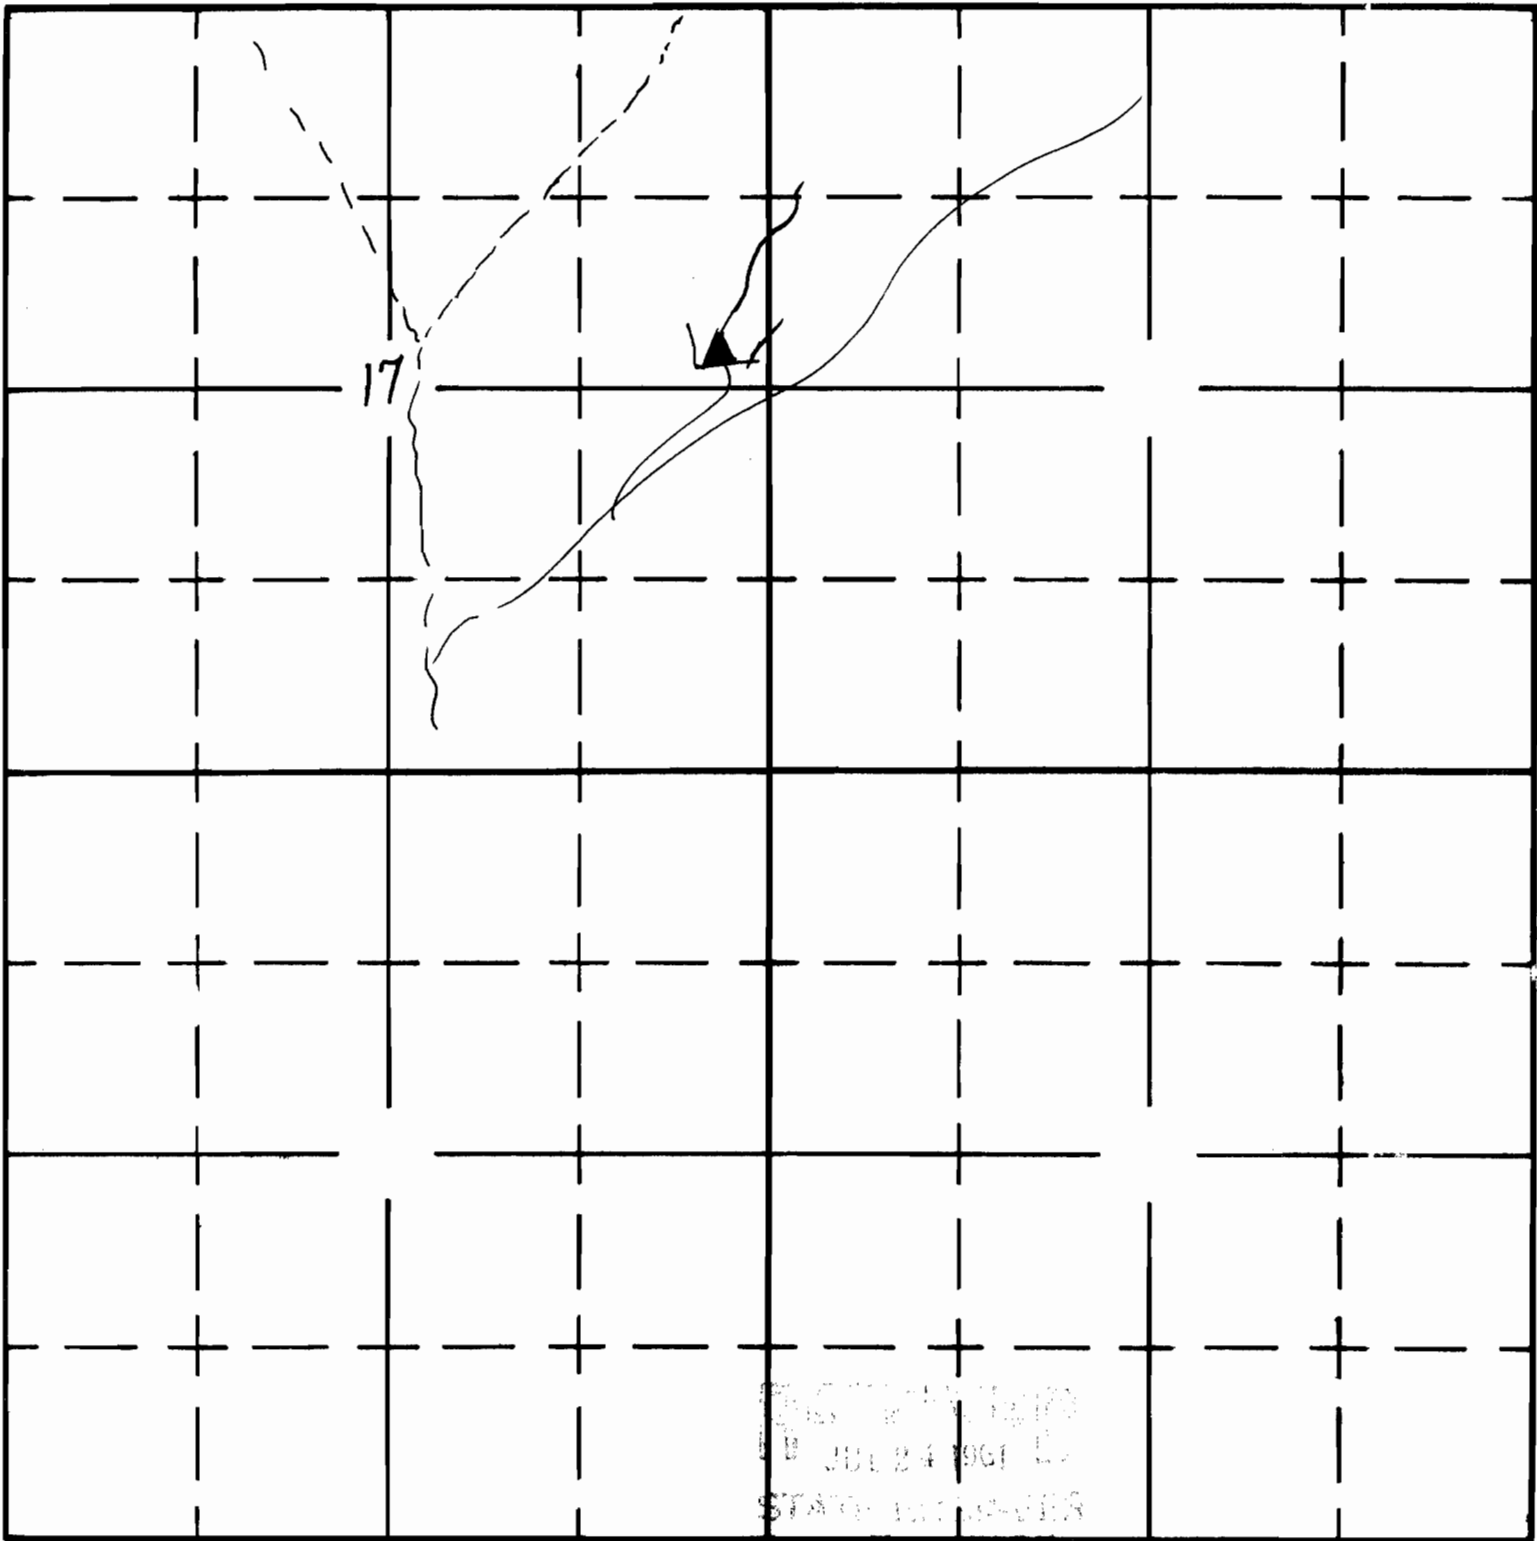

South

RECEIVED
JUL 24 1961
STATE OF OREGON
BUREAU OF LAND MANAGEMENT

APPLICATION No. R-35458
PERMIT No. R-3823