

UNITED STATES
DEPARTMENT OF THE INTERIOR
BUREAU OF LAND MANAGEMENT

SECTION


SE 1/4 SE 1/4

Oregon State Water Filings

8

TOWNSHIP 29S, RANGE 24E, W. M.

North

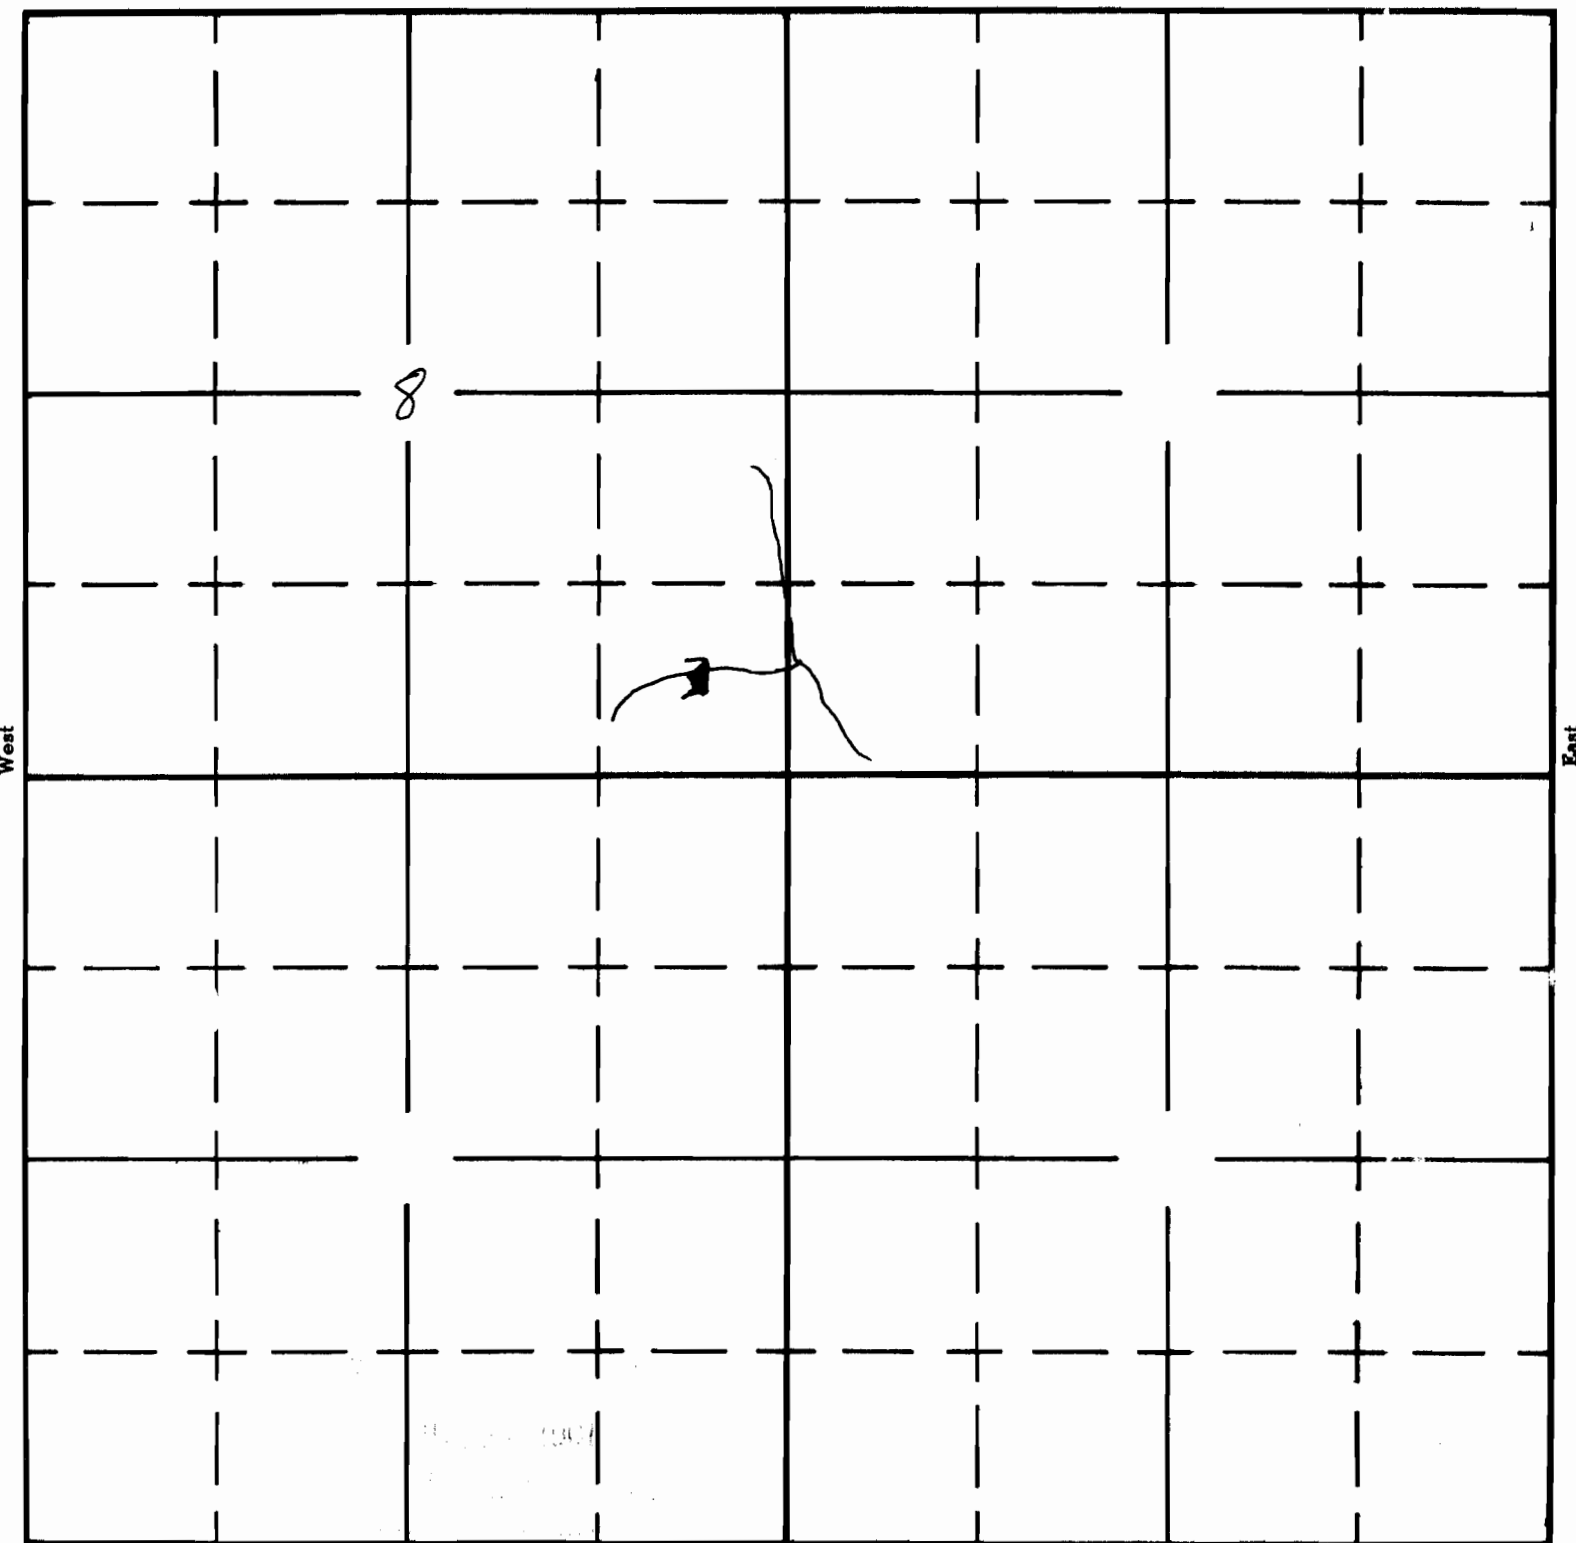

South

APPLICATION No. R-35464
PERMIT No. R-3327