

Project 02-1063


Form AI-187
March 1961

UNITED STATES
DEPARTMENT OF THE INTERIOR
BUREAU OF LAND MANAGEMENT

SECTION
SW 1/4 SE 1/4
22

Oregon State Water Filings

TOWNSHIP 29S, RANGE 34E, W. M.

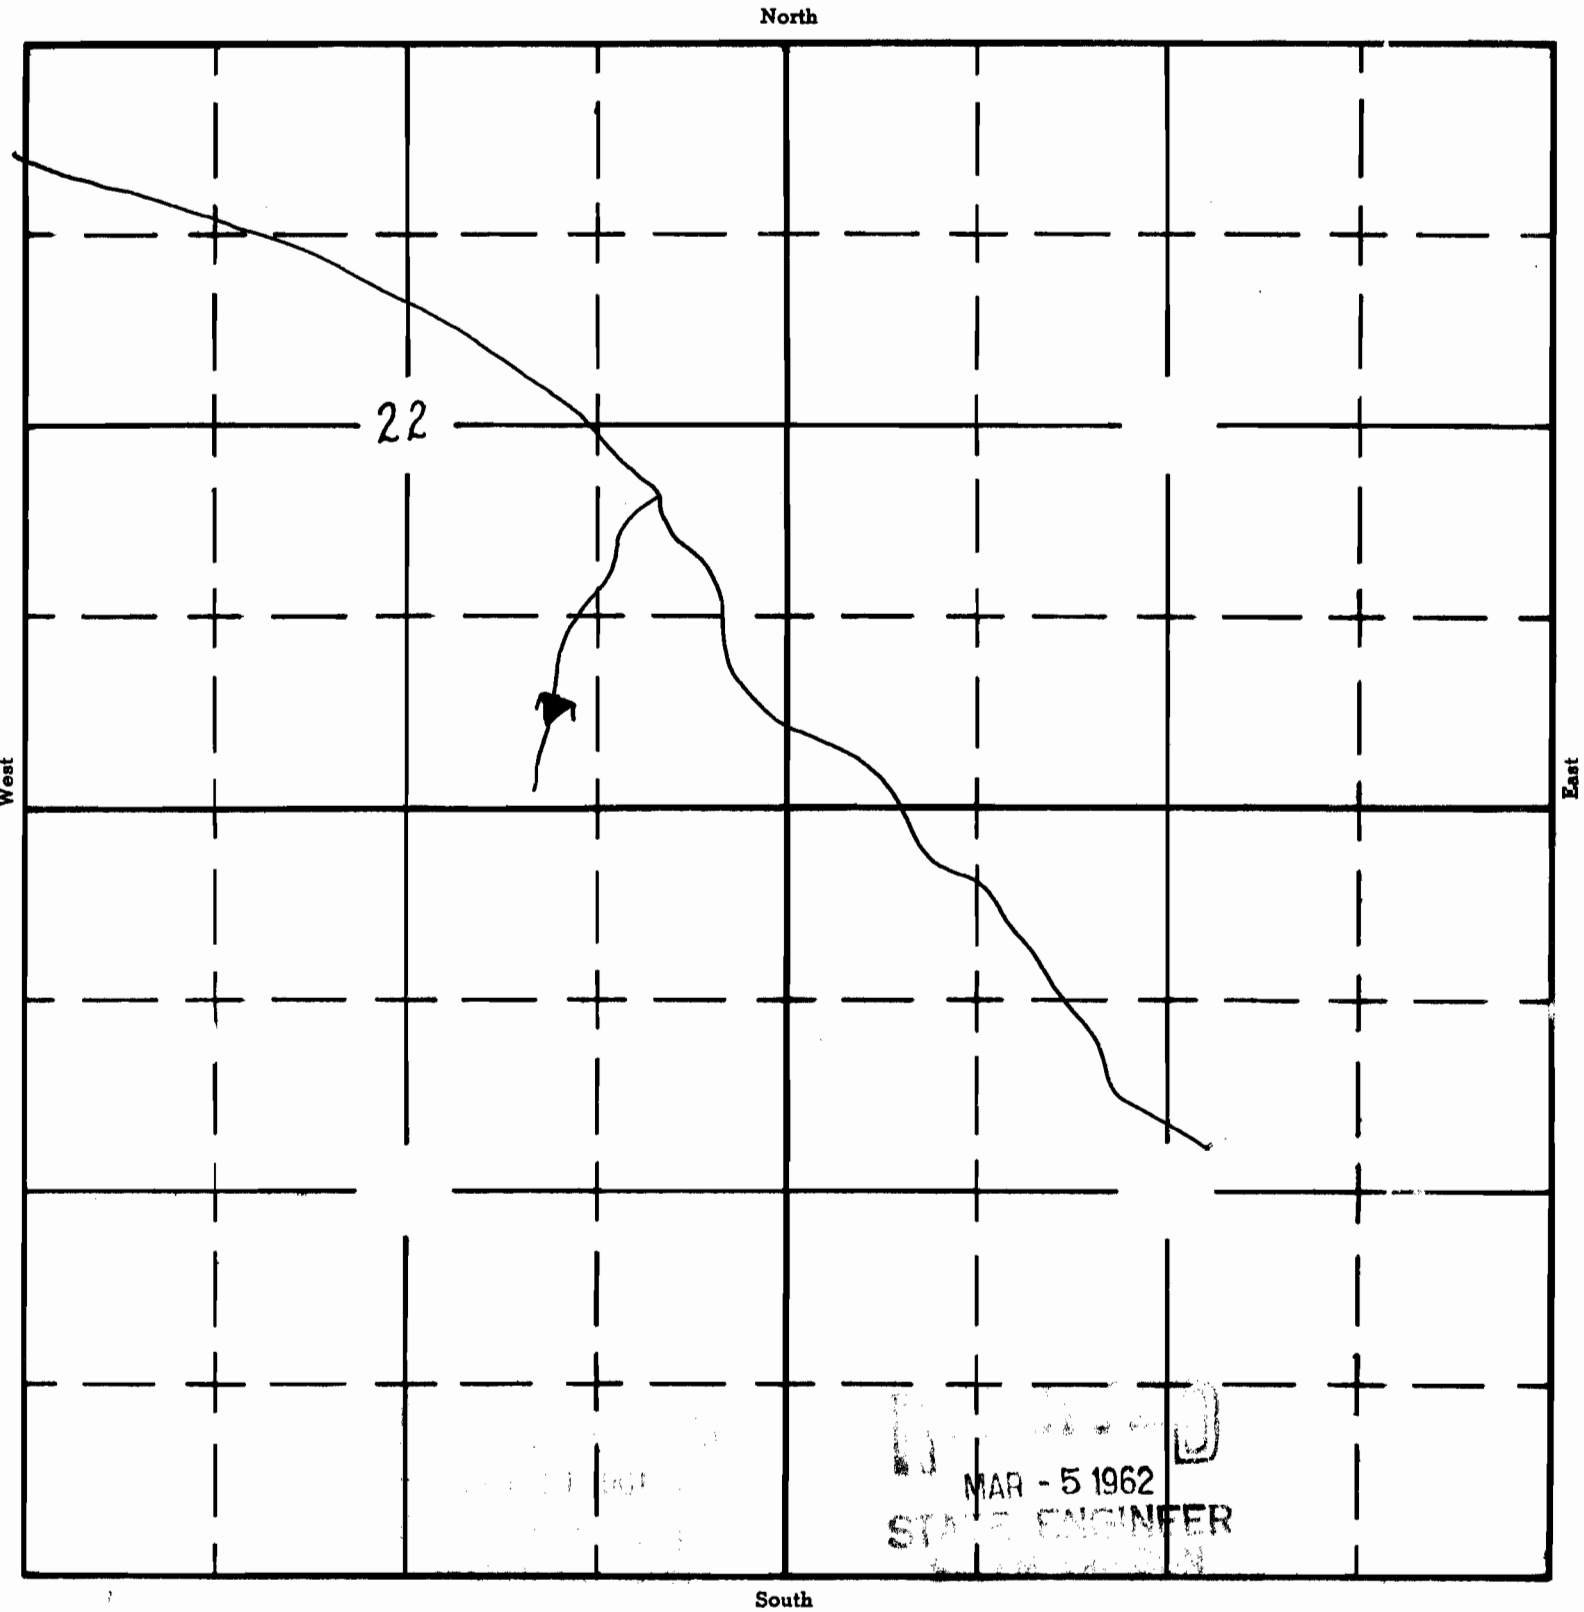

APPLICATION No. R-35466
PERMIT No. R-3329