

UNITED STATES
DEPARTMENT OF THE INTERIOR
BUREAU OF LAND MANAGEMENT

SECTION


SW 1/4 NE 1/4

Oregon State Water Filings

27

TOWNSHIP 29S, RANGE 34E, W. M.

North

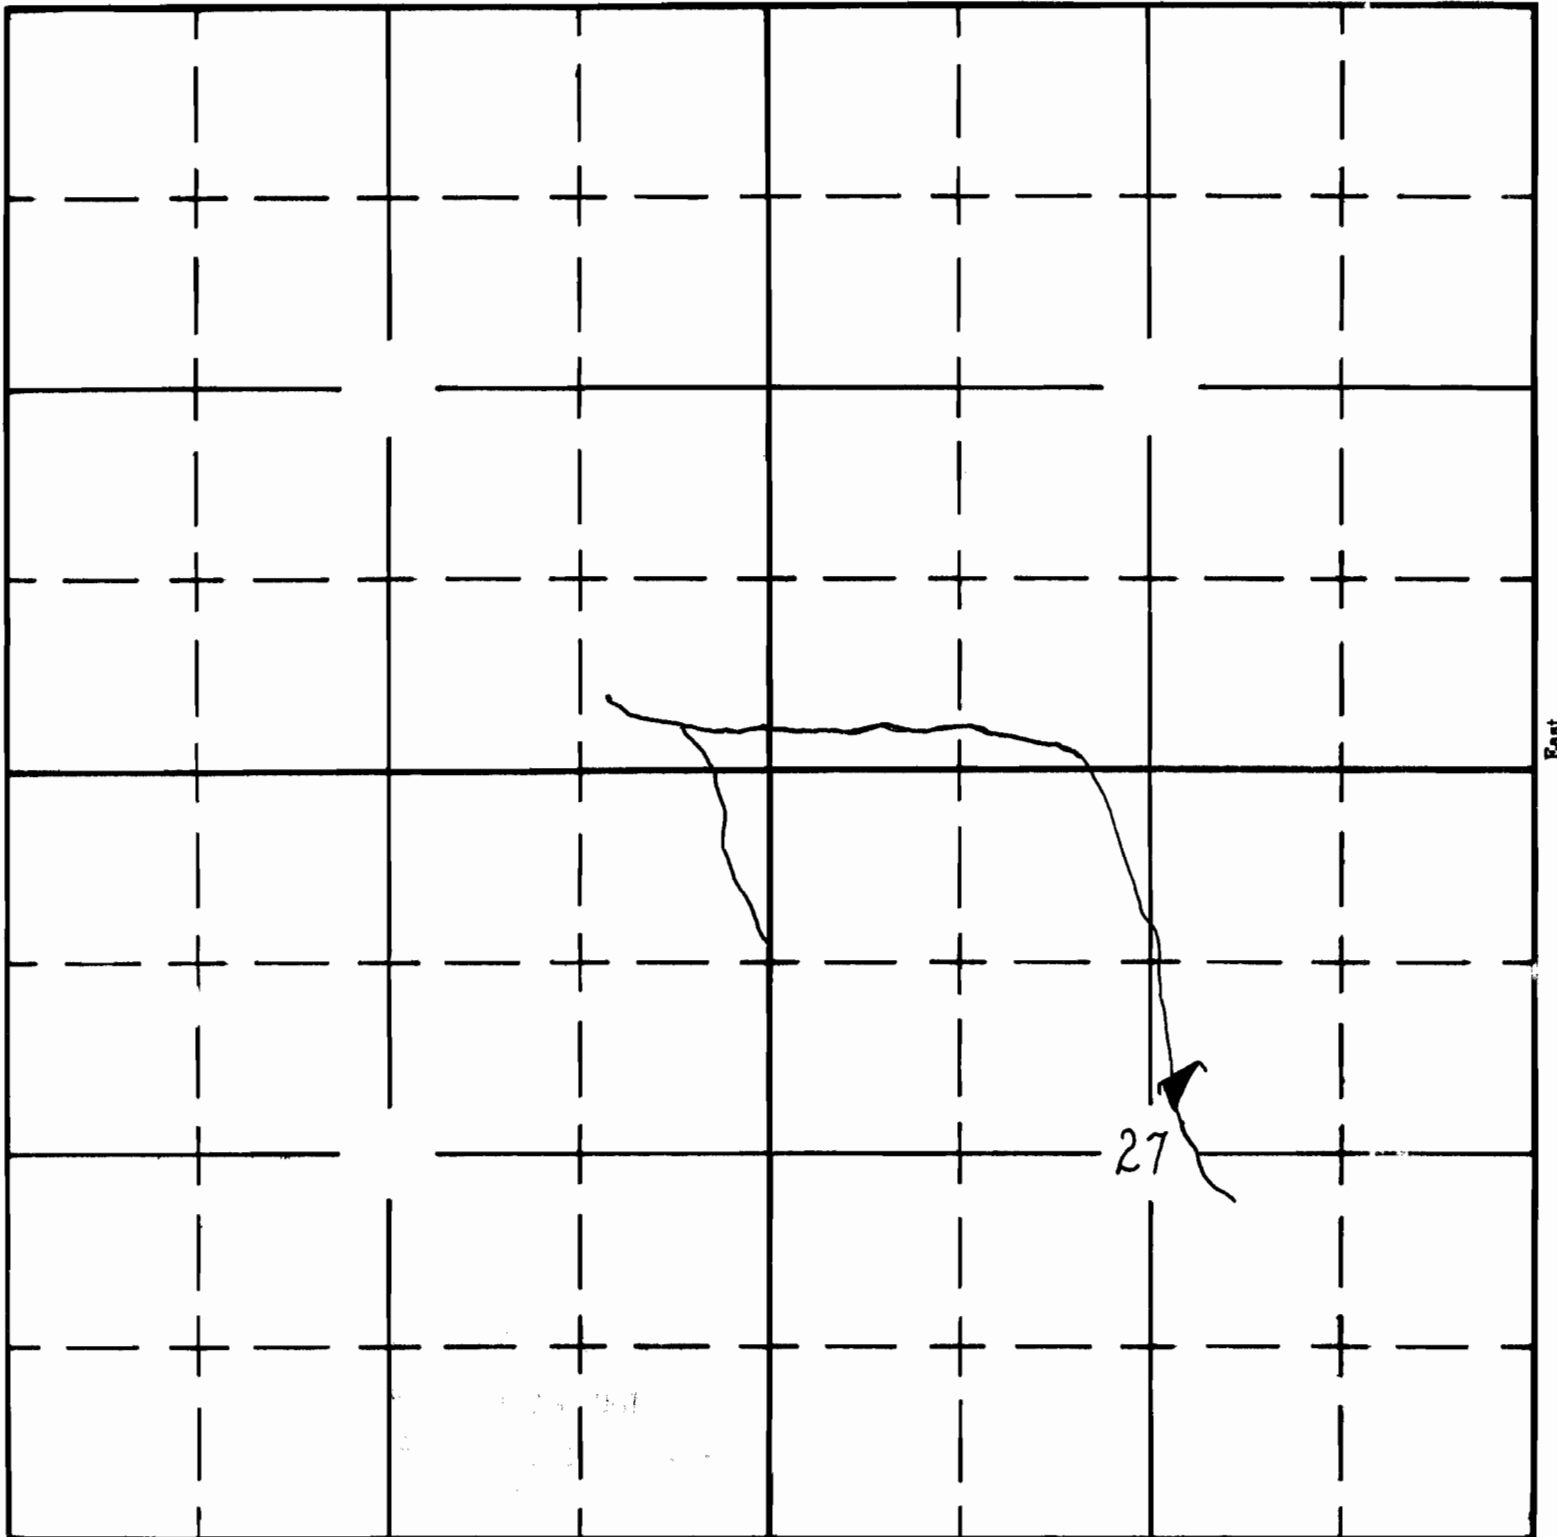

South

APPLICATION No. R-35467
PERMIT No. R-3330