


UNITED STATES
DEPARTMENT OF THE INTERIOR
BUREAU OF LAND MANAGEMENT

SECTION NE 1/4
SEC. 9

Oregon State Water Filings

TOWNSHIP 30 S, RANGE 34 E, W. M.

North

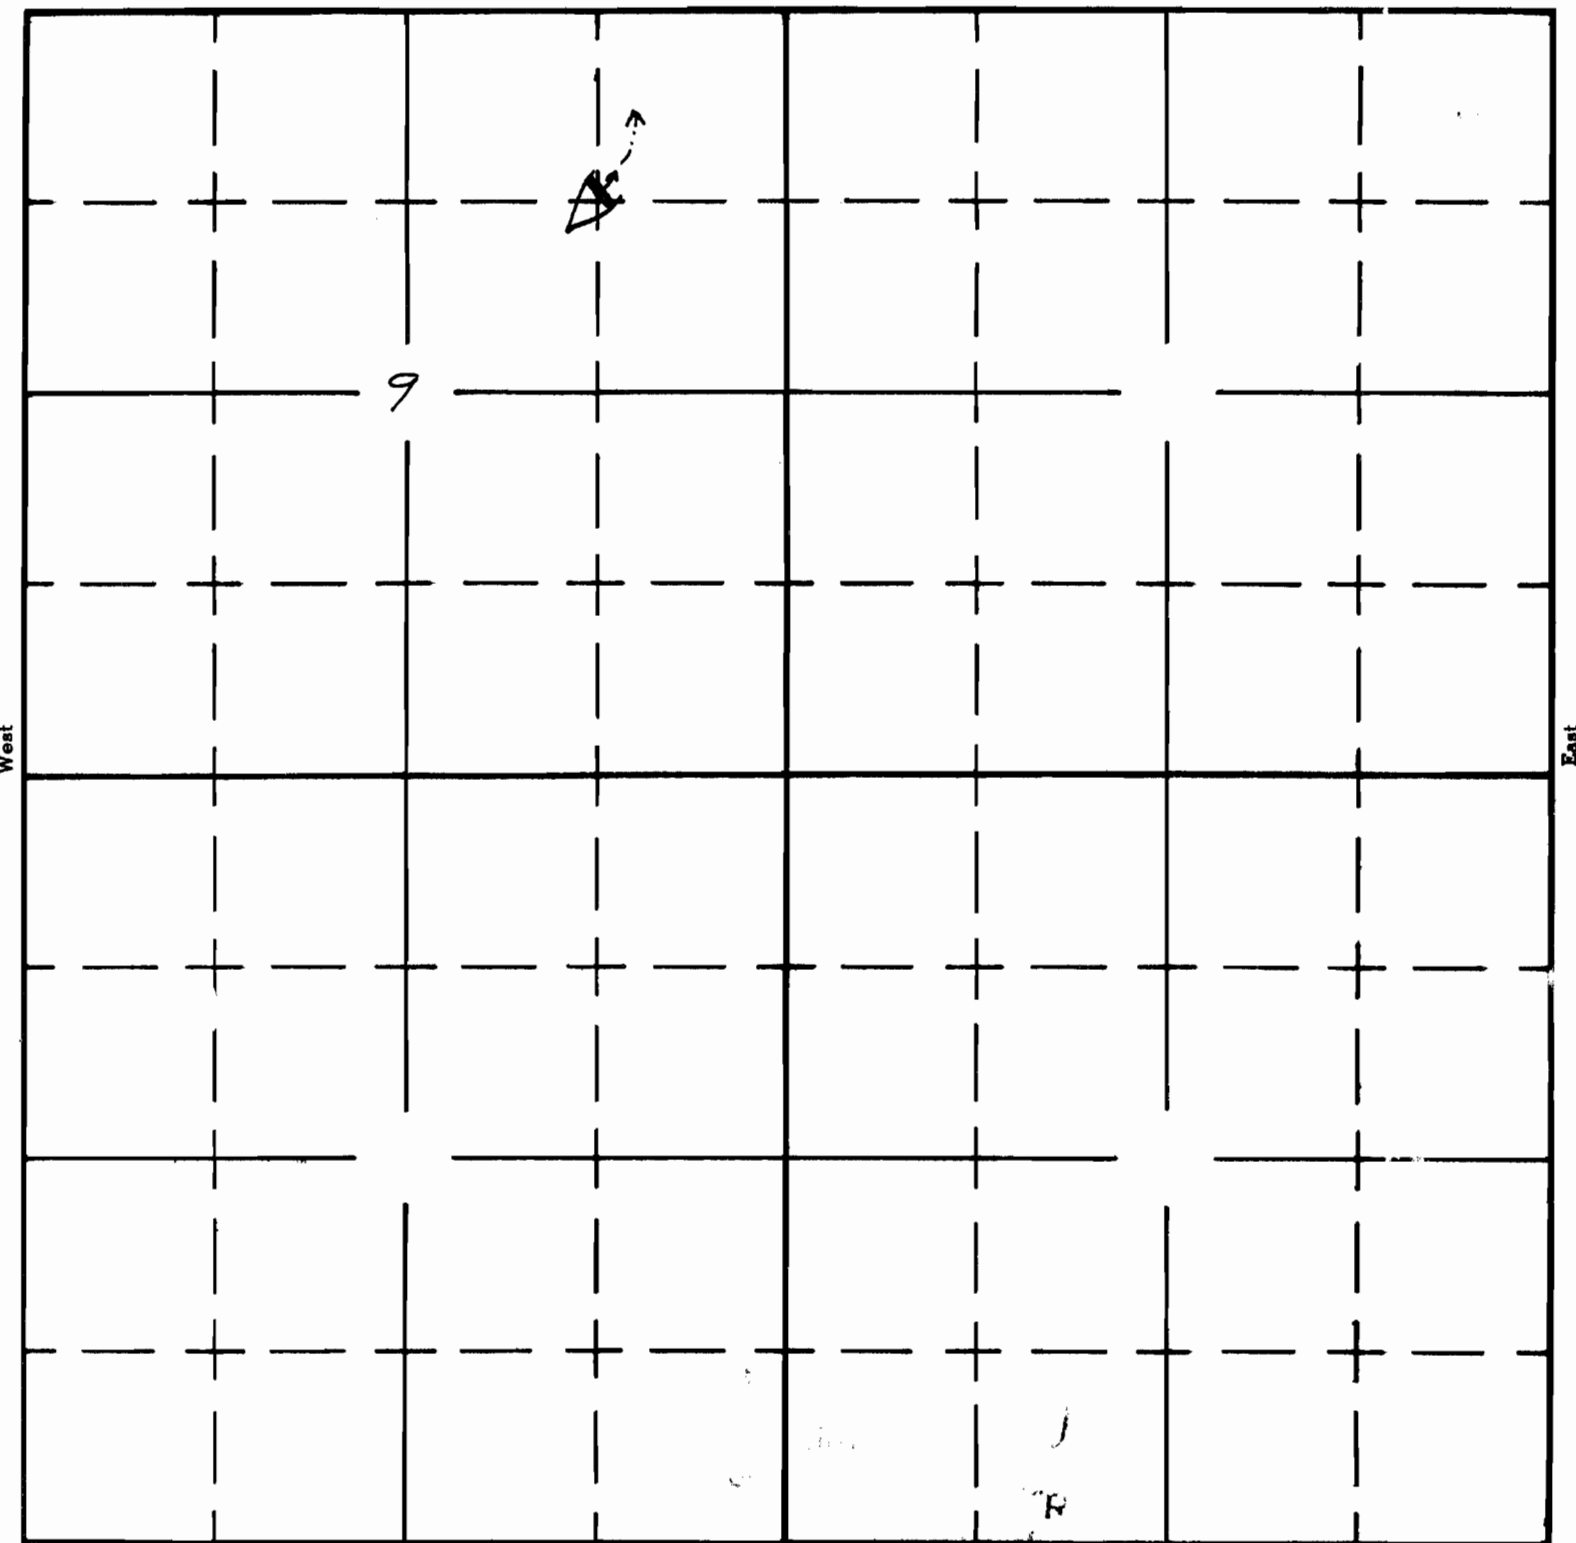

South

APPLICATION No. R-35347
PERMIT No. R-3351