


Form A1-187
March 1961

UNITED STATES
DEPARTMENT OF THE INTERIOR
BUREAU OF LAND MANAGEMENT

SECTION
NW¹/₄ NW¹/₄
SEC. 8

Oregon State Water Filings
TOWNSHIP 30 S, RANGE 34 E, W. M.

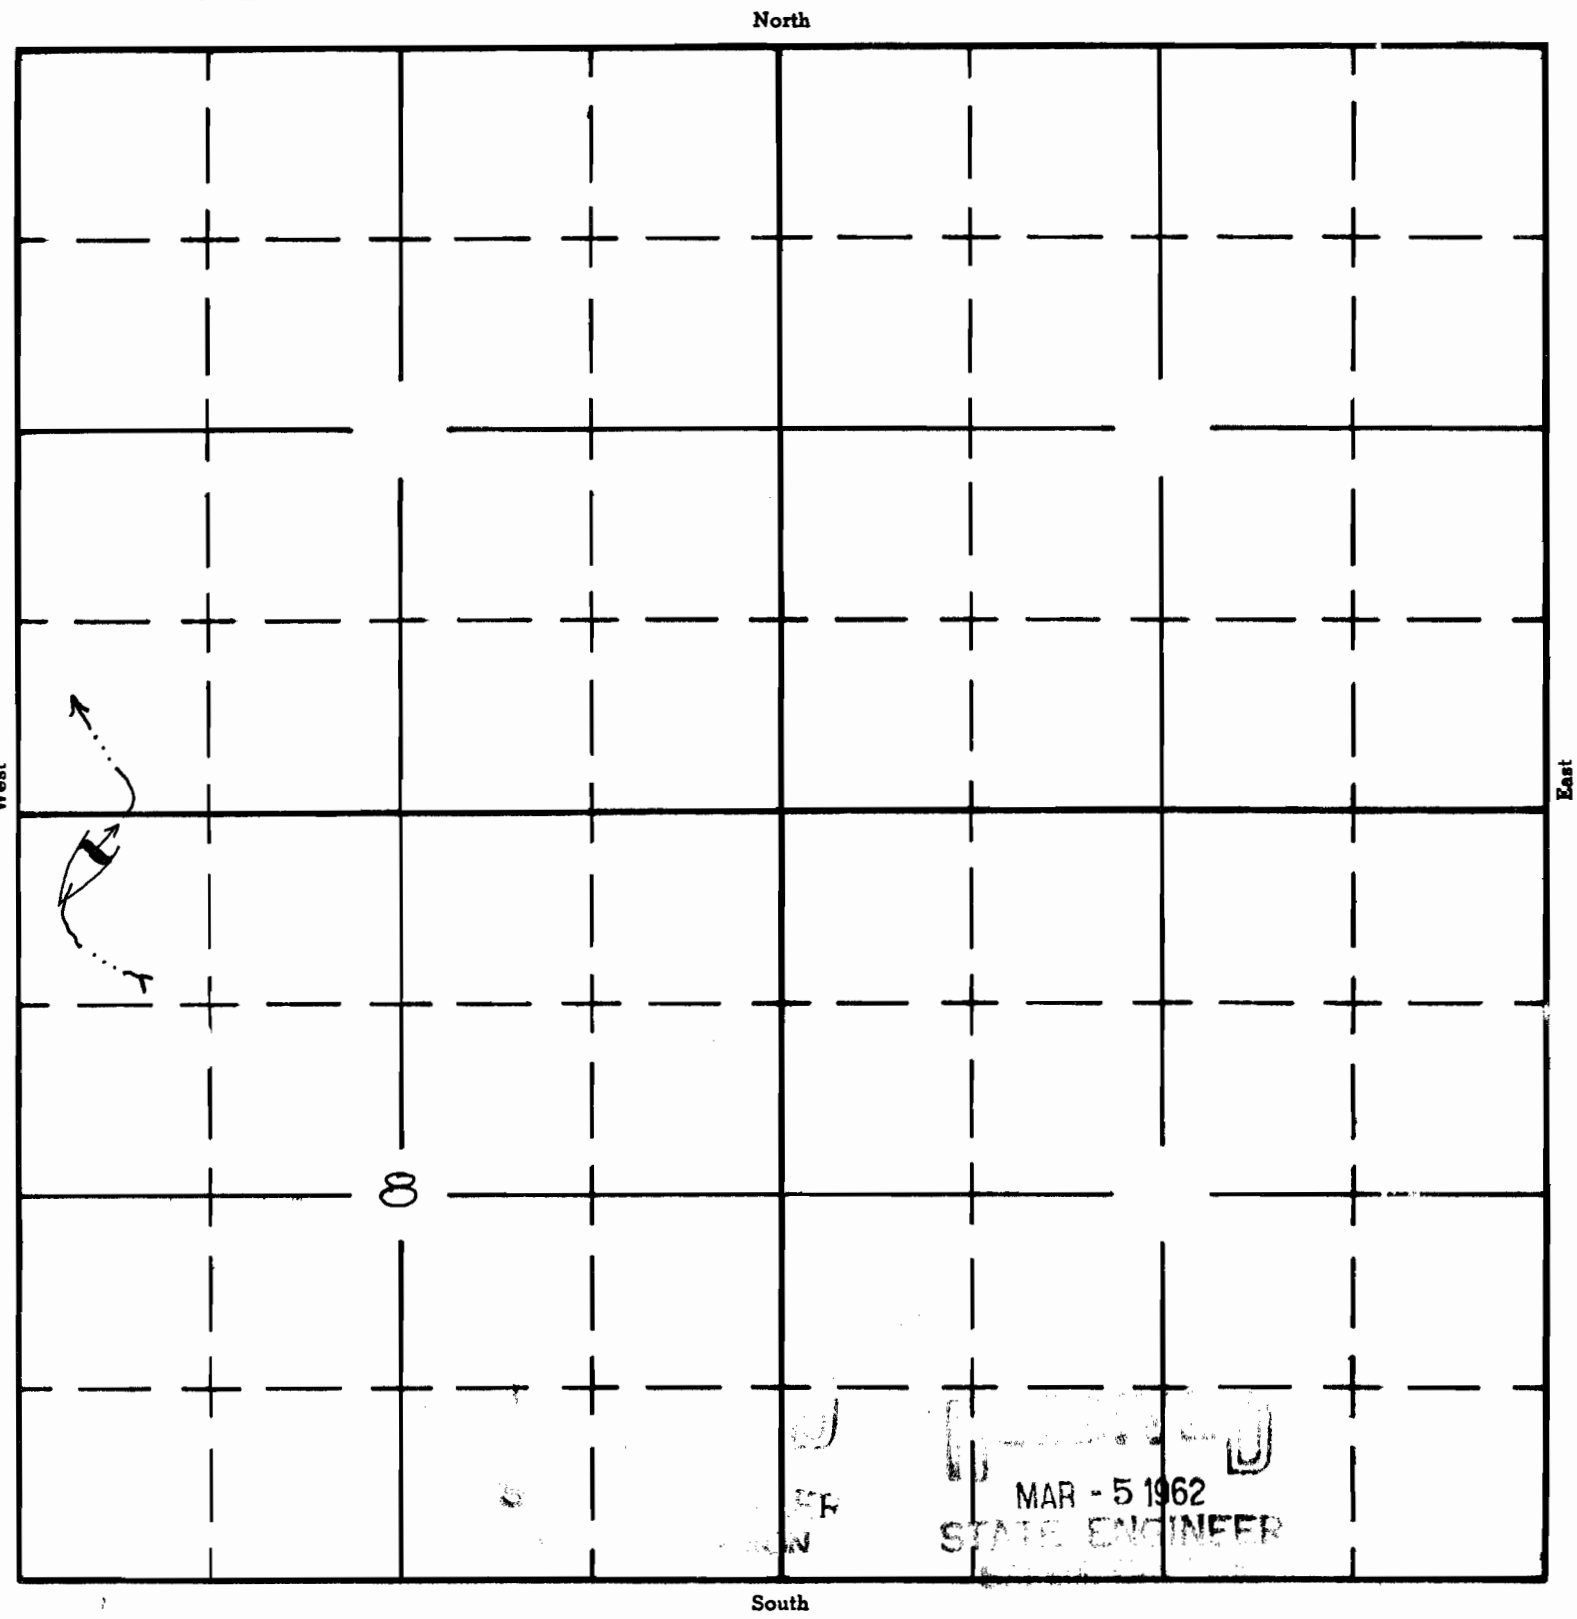

APPLICATION No. R-35349
PERMIT No. R-3353