

Form A1-187
March 1961

UNITED STATES
DEPARTMENT OF THE INTERIOR
BUREAU OF LAND MANAGEMENT

SECTION


SW $\frac{1}{4}$ NW $\frac{1}{4}$

SEC. 11

Oregon State Water Filings

TOWNSHIP 30S, RANGE 34E, W. M.

North

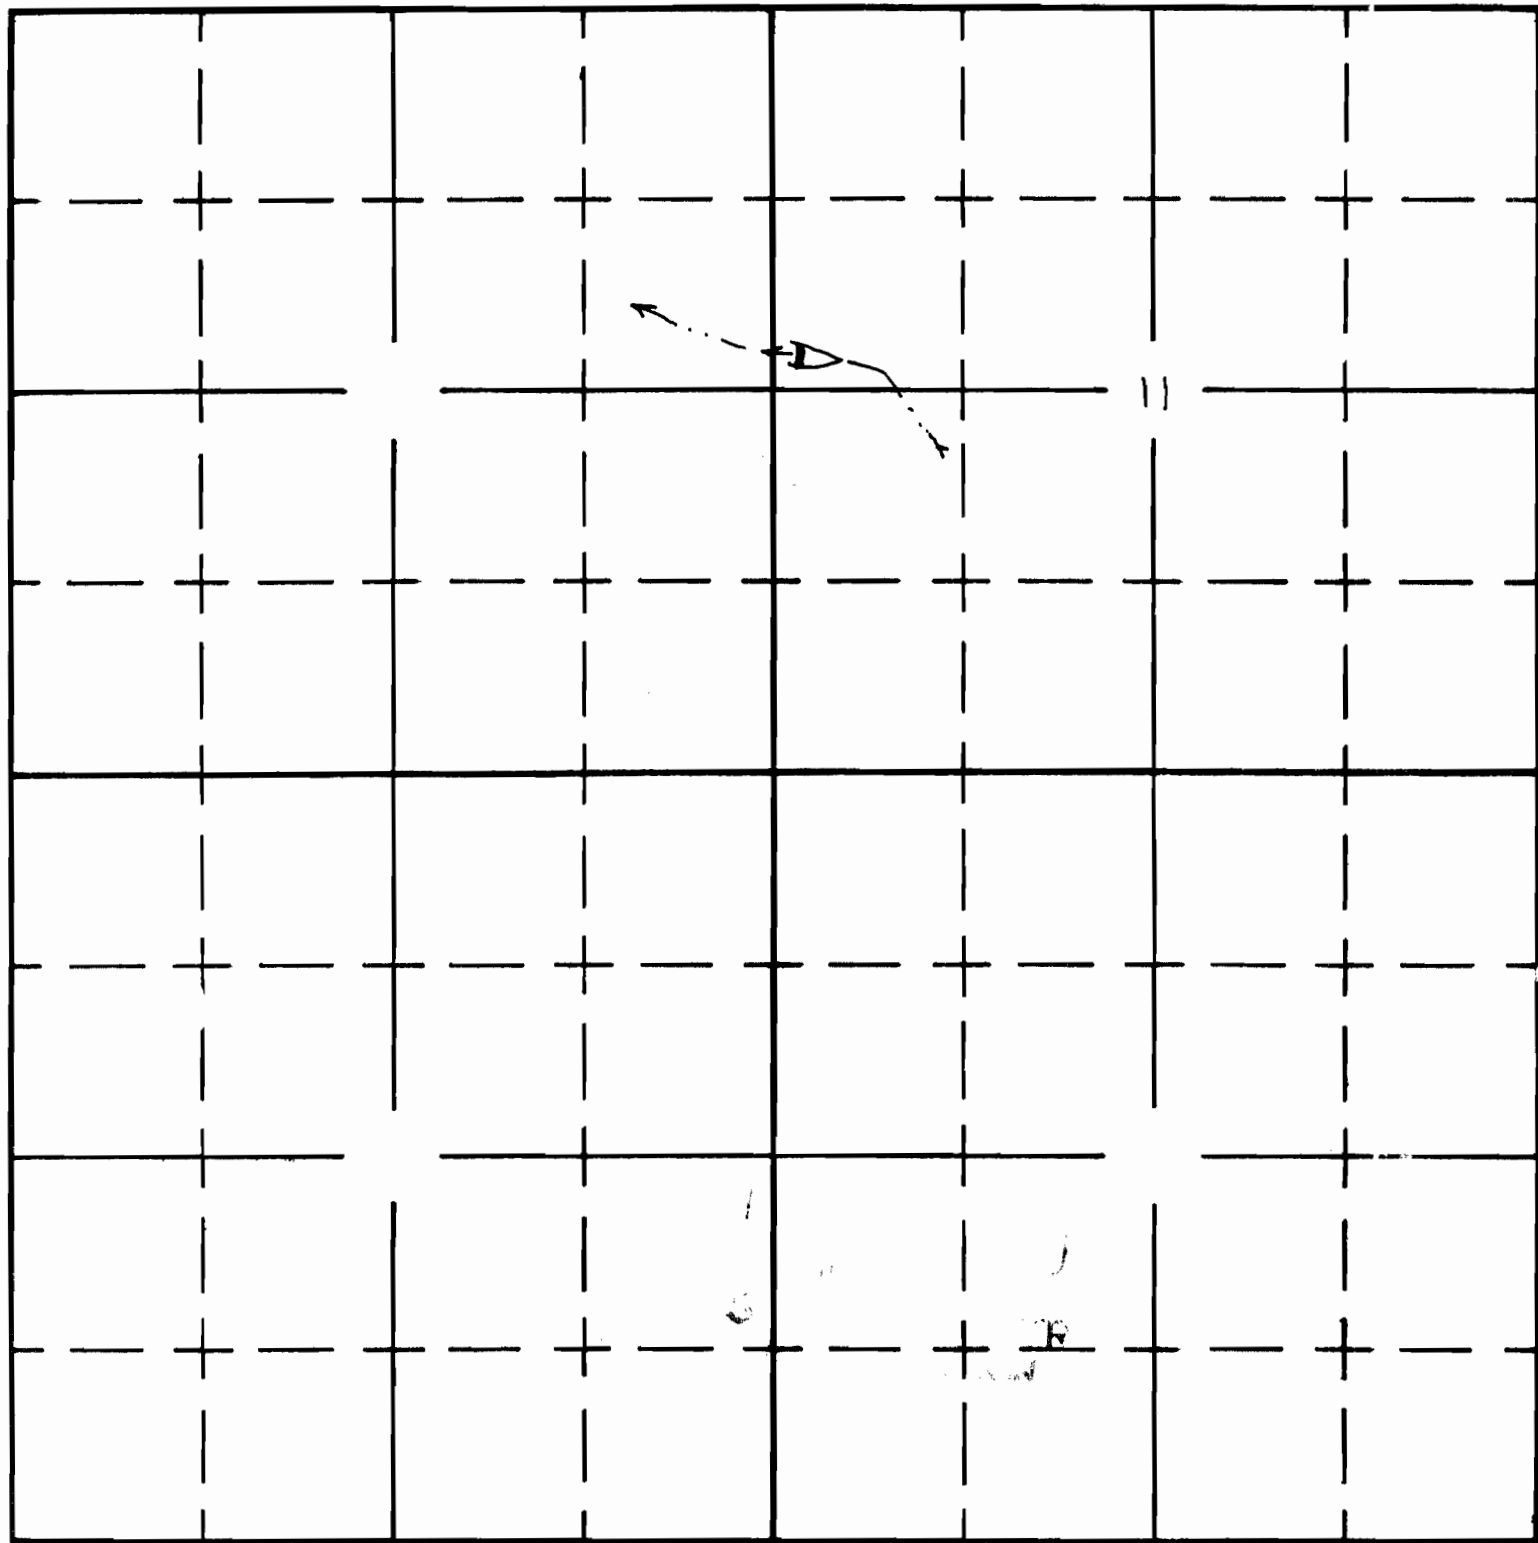

South

APPLICATION No. R-35362
PERMIT No. R-3360