


Form AI-187
March 1961

UNITED STATES
DEPARTMENT OF THE INTERIOR
BUREAU OF LAND MANAGEMENT

SECTION
SW 1/4 NE 1/4
SEC. 3

Oregon State Water Filings
TOWNSHIP 30 S, RANGE 34 E, W. M.

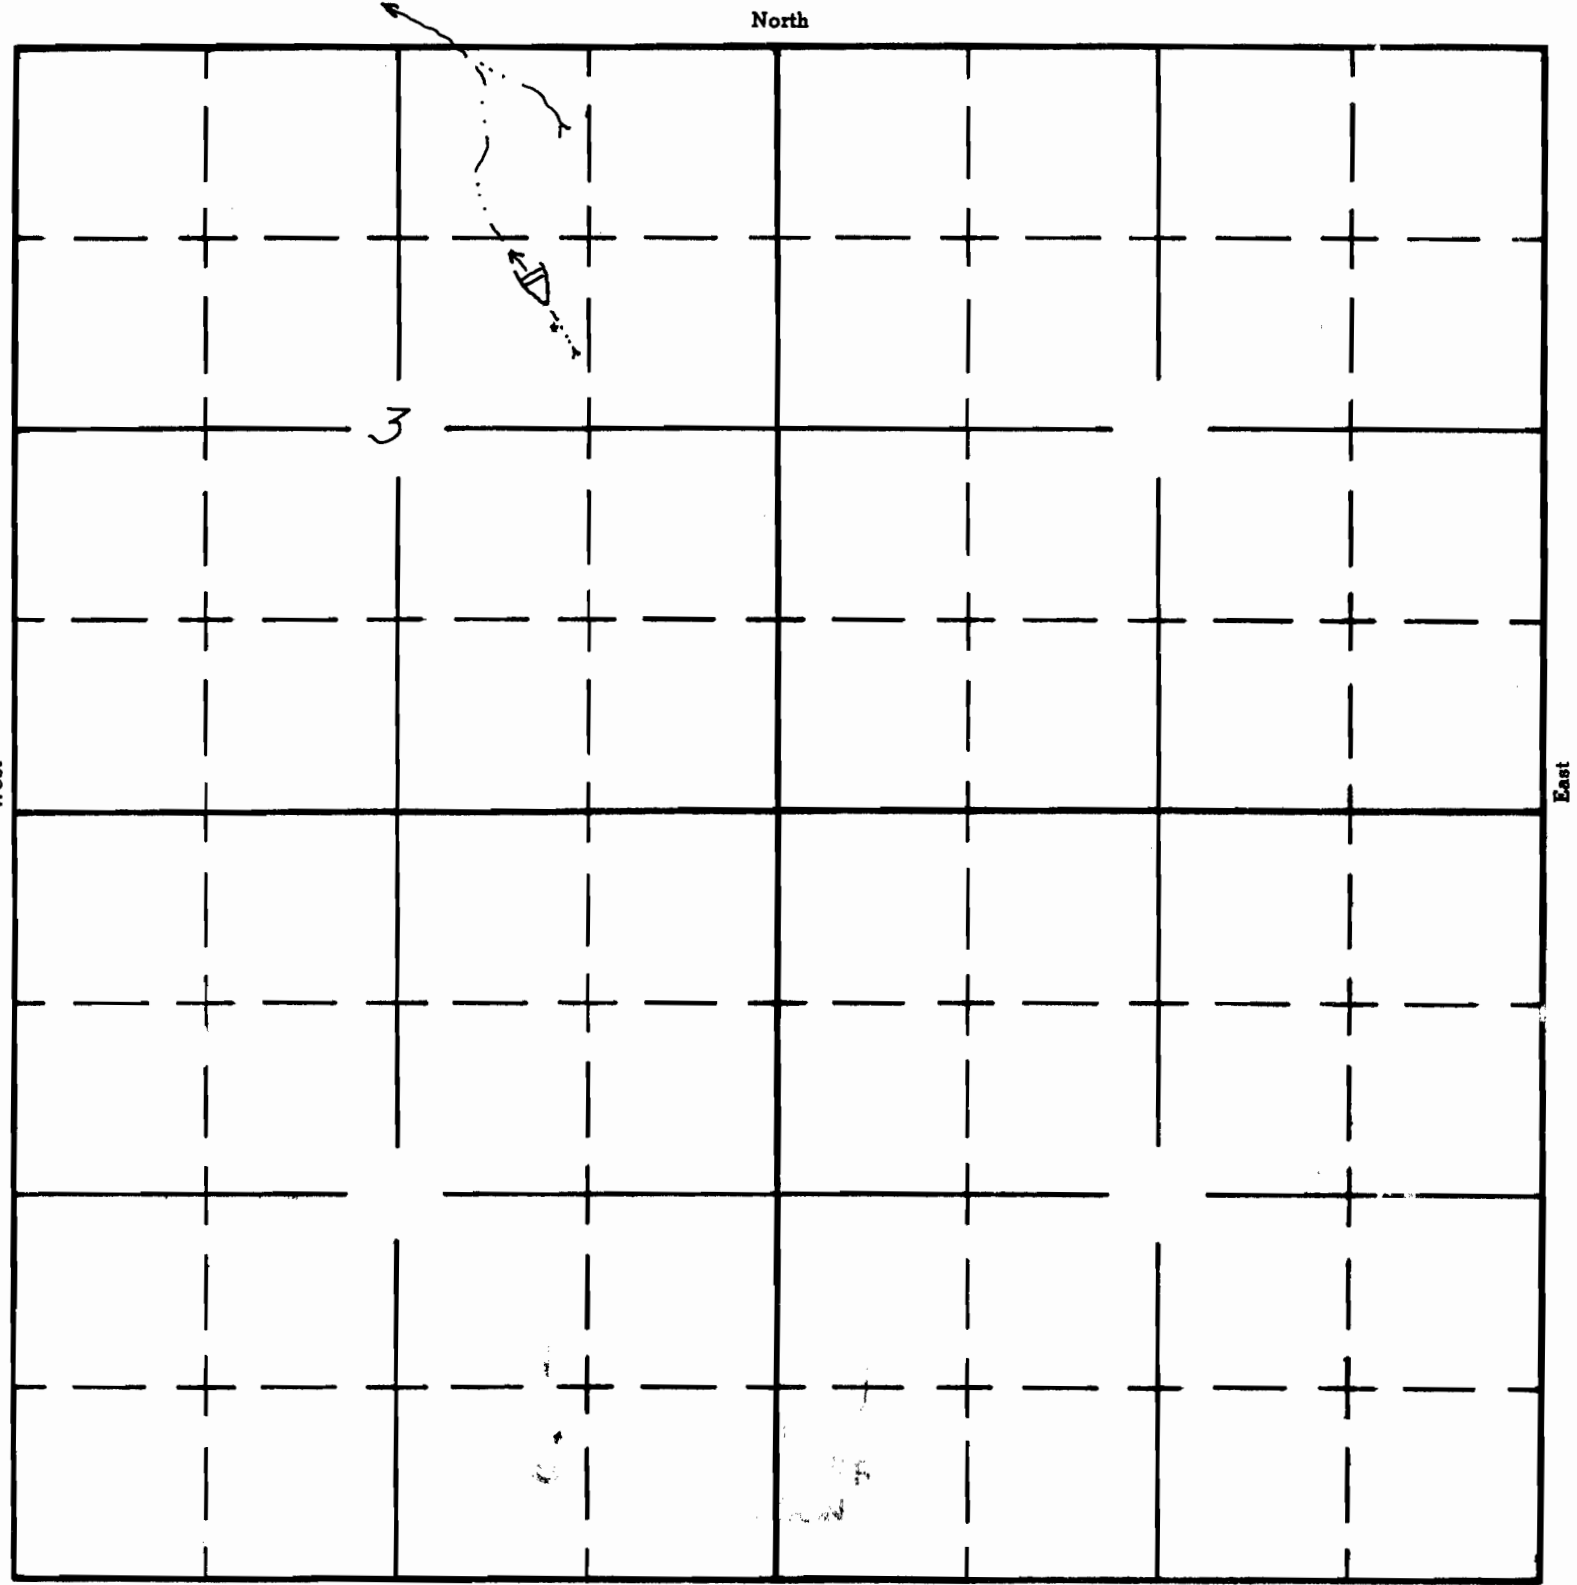

UNNAMED
Long CC

APPLICATION No R-35363
PERMIT No. R-8361