

Form A1-187
March 1961

UNITED STATES
DEPARTMENT OF THE INTERIOR
BUREAU OF LAND MANAGEMENT

SECTION


SW 1/4 SE 1/4

Oregon State Water Filings

SEC. 29.

TOWNSHIP 29S, RANGE 34E, W. M.

North

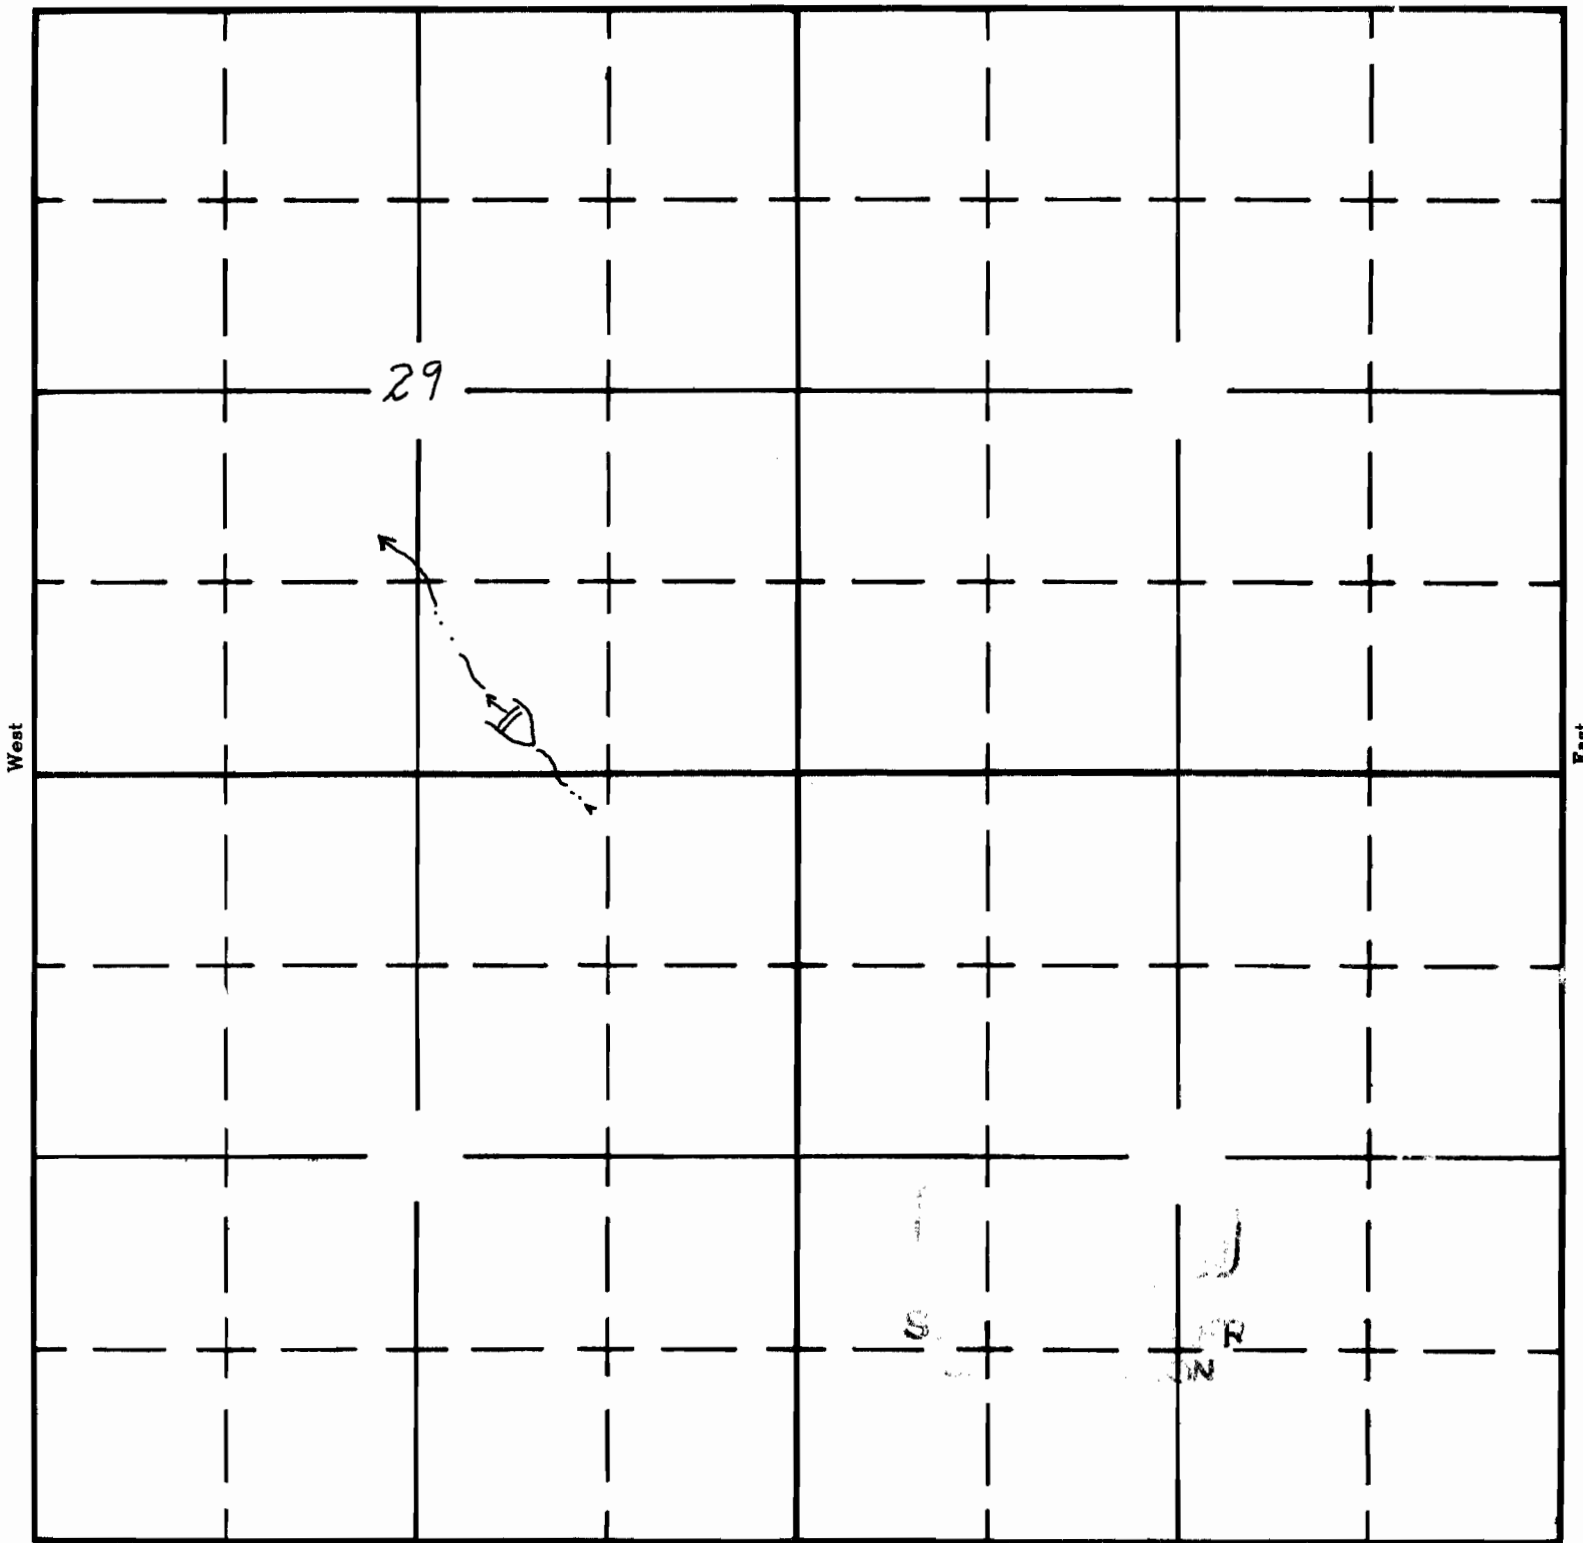

South

*Enclosed
by 10*

APPLICATION No. R-35365

PERMIT No. R-3863