

Form AI-187
March 1961

UNITED STATES
DEPARTMENT OF THE INTERIOR
BUREAU OF LAND MANAGEMENT

SECTION


27

Oregon State Water Filings

TOWNSHIP 21S, RANGE 29E, W. M. 02-R-293

STATE ENGINEER
DALE O. JON

North

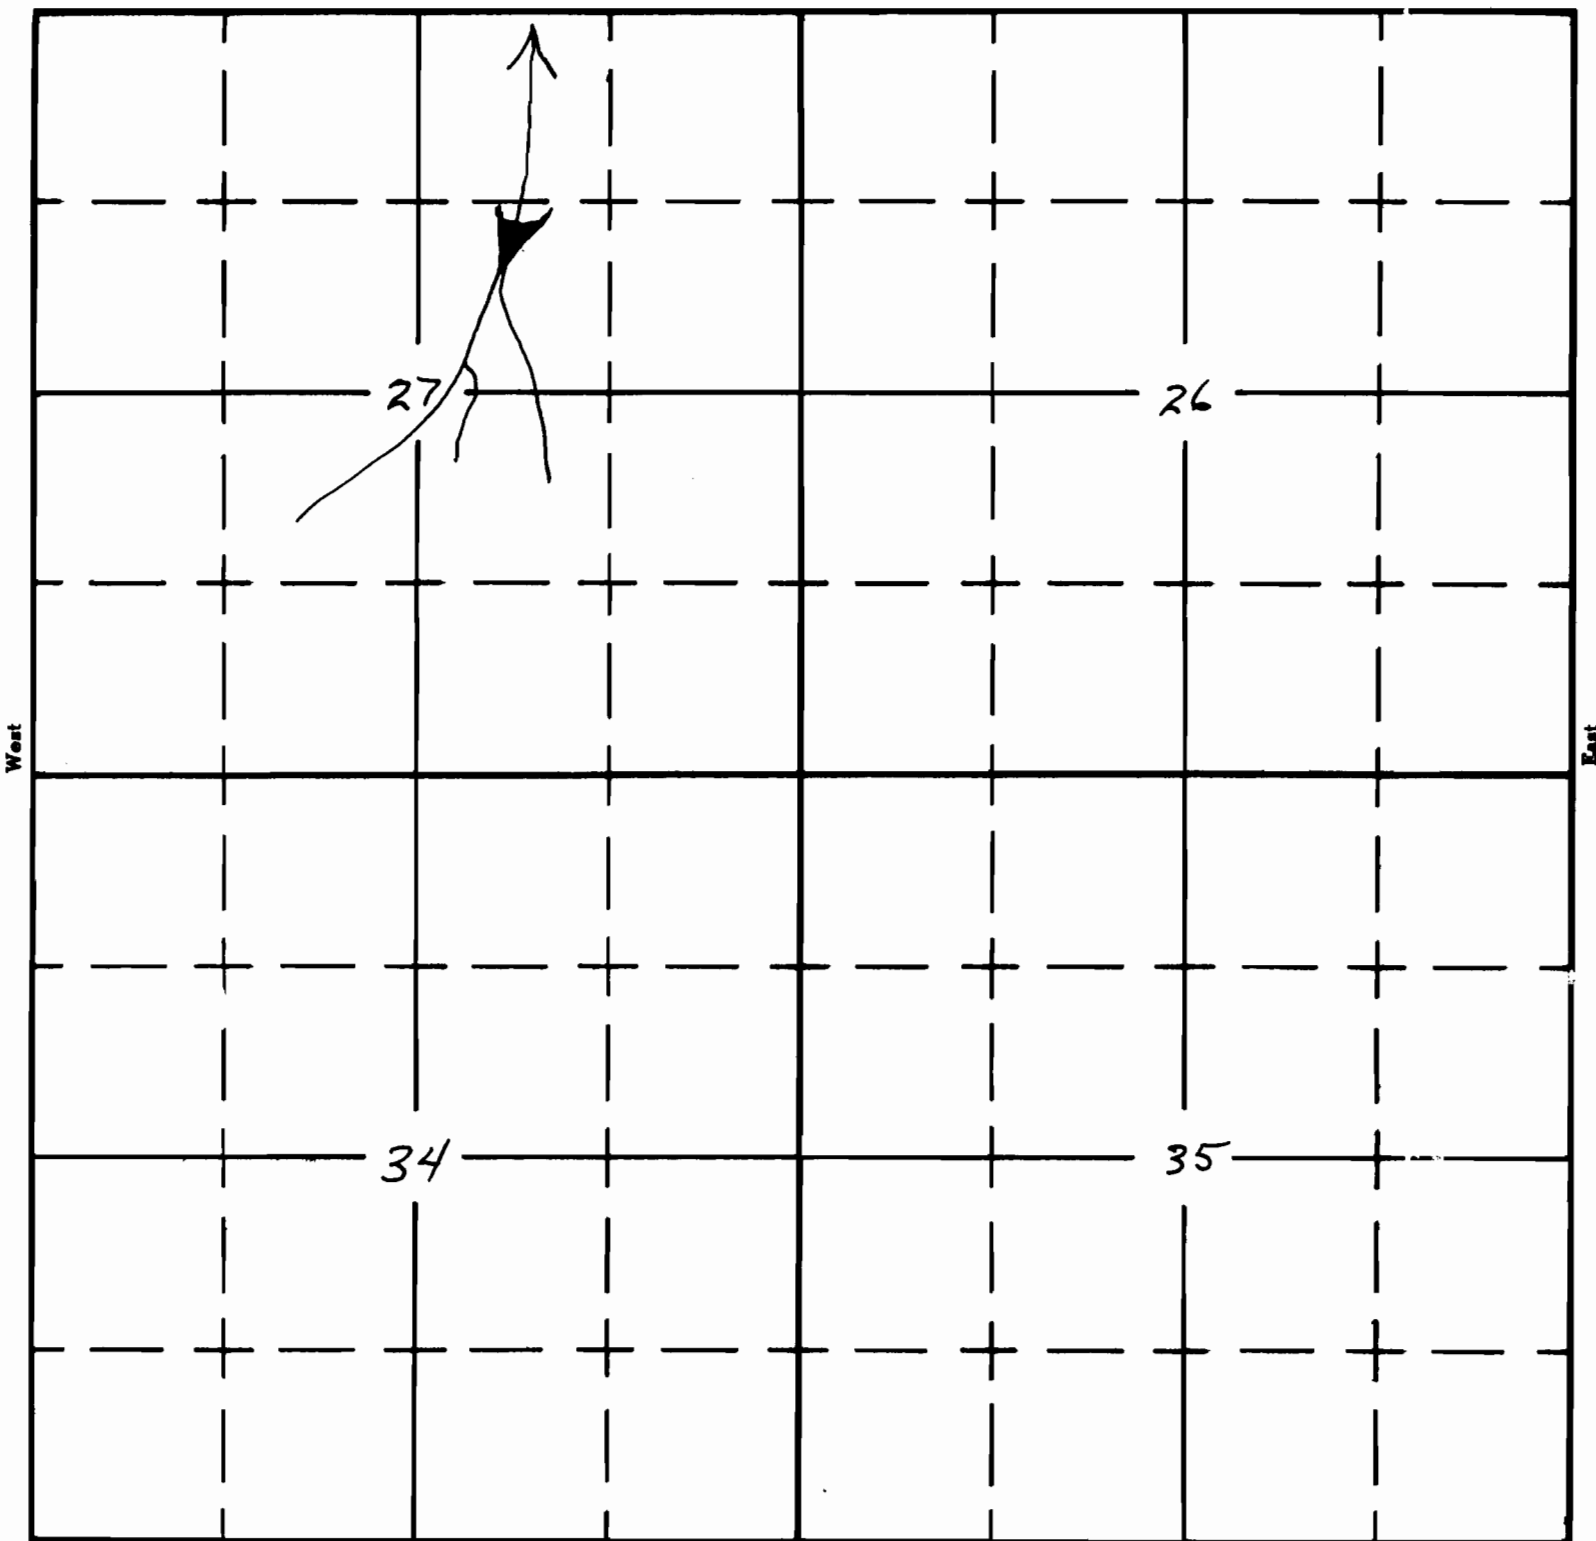

South

APPLICATION No. R-38978
PERMIT No. R-3467