

UNITED STATES
DEPARTMENT OF THE INTERIOR
BUREAU OF LAND MANAGEMENT

SECTION


Oregon State Water Filings

SE 1/4 SE 1/4

TOWNSHIP 29 S, RANGE 33 E, W. M.

Sec 4

North

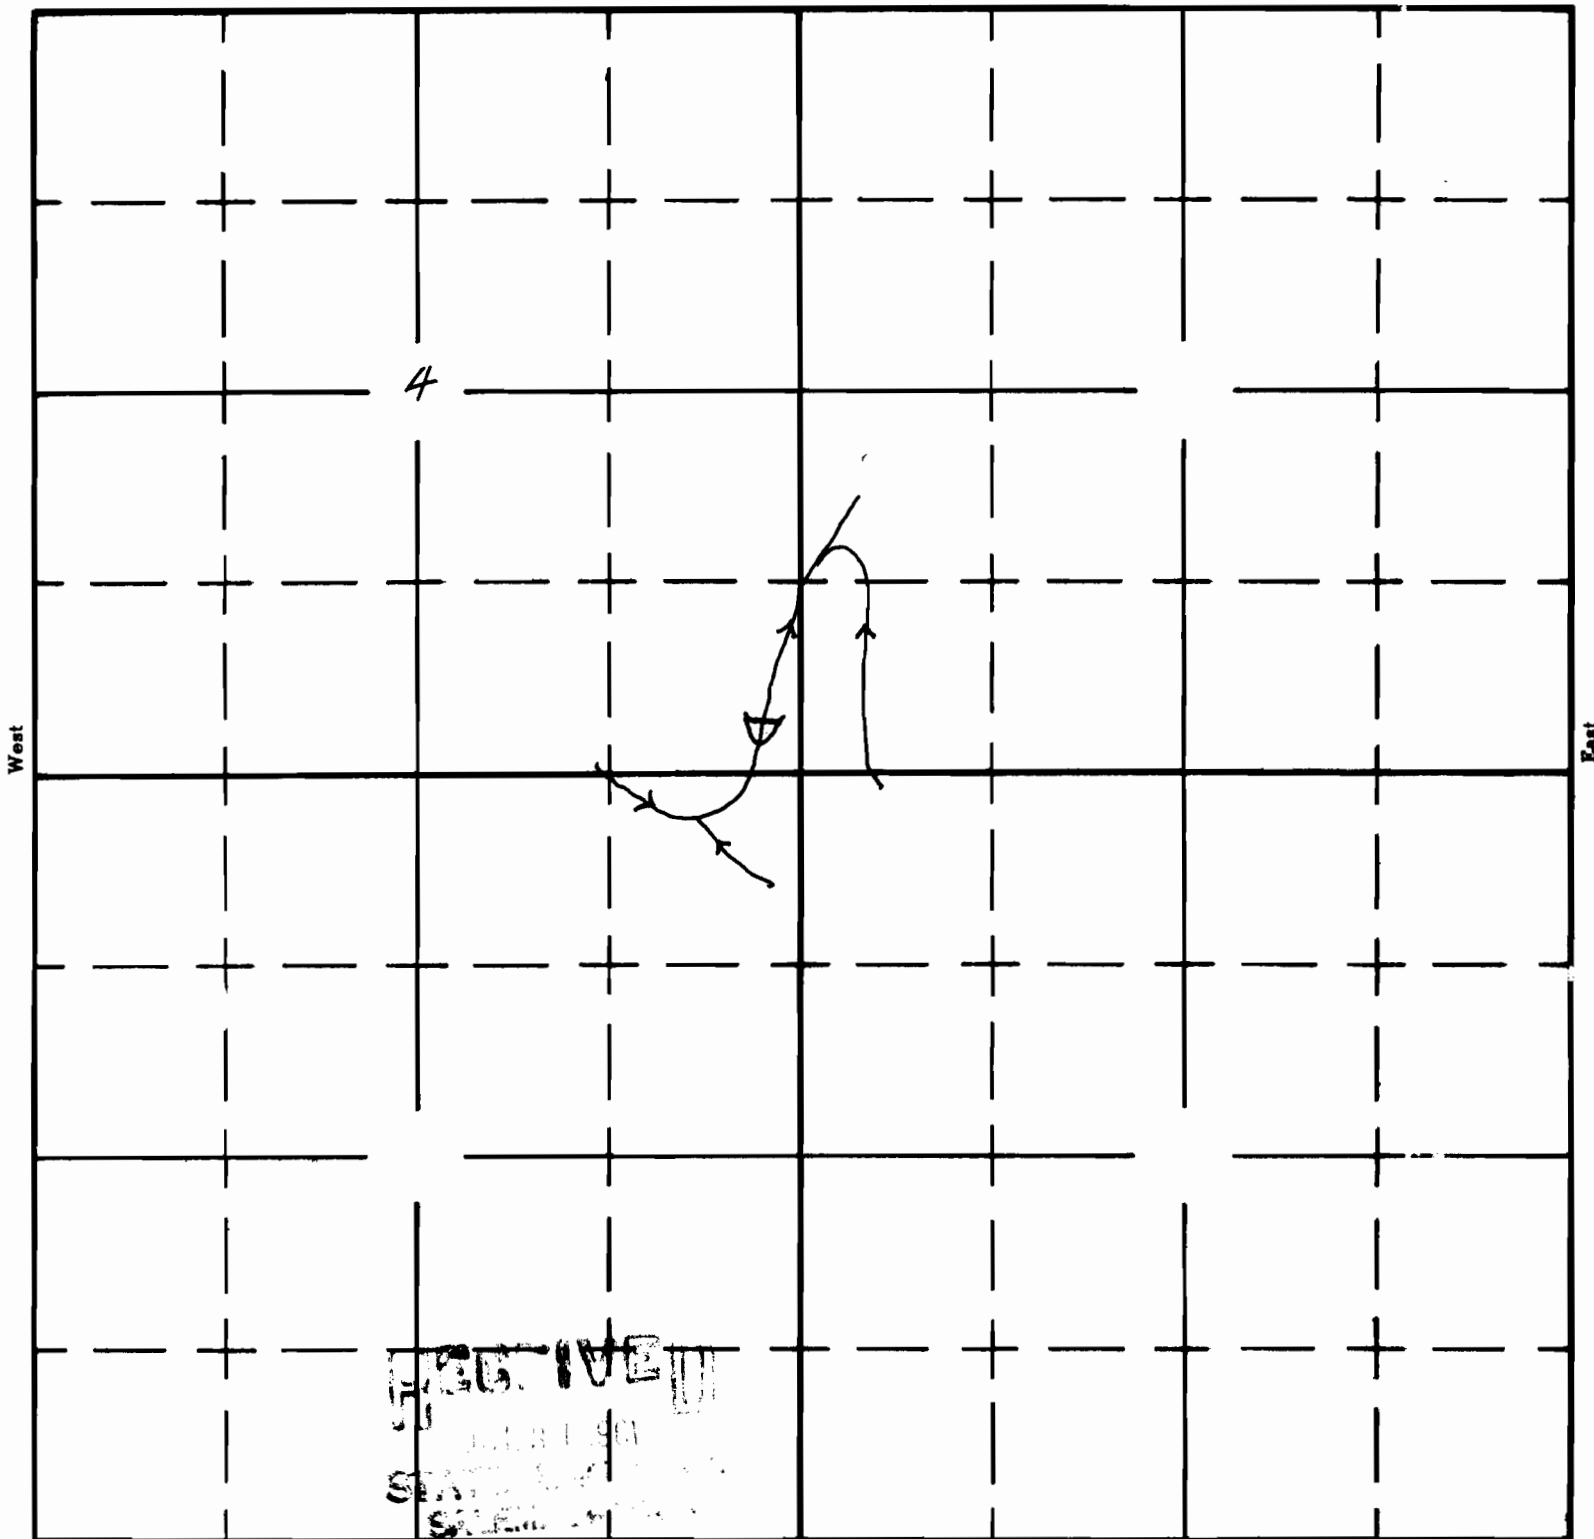

APPLICATION No. R-35826
PERMIT No. R-3475