

Form A1-187
March 1961

UNITED STATES
DEPARTMENT OF THE INTERIOR
BUREAU OF LAND MANAGEMENT

SECTION

SE 1/4 NE 1/4

Oregon State Water Filings


SEC. 19

TOWNSHIP 29 S, RANGE 36 E, W. M.

North

West

East

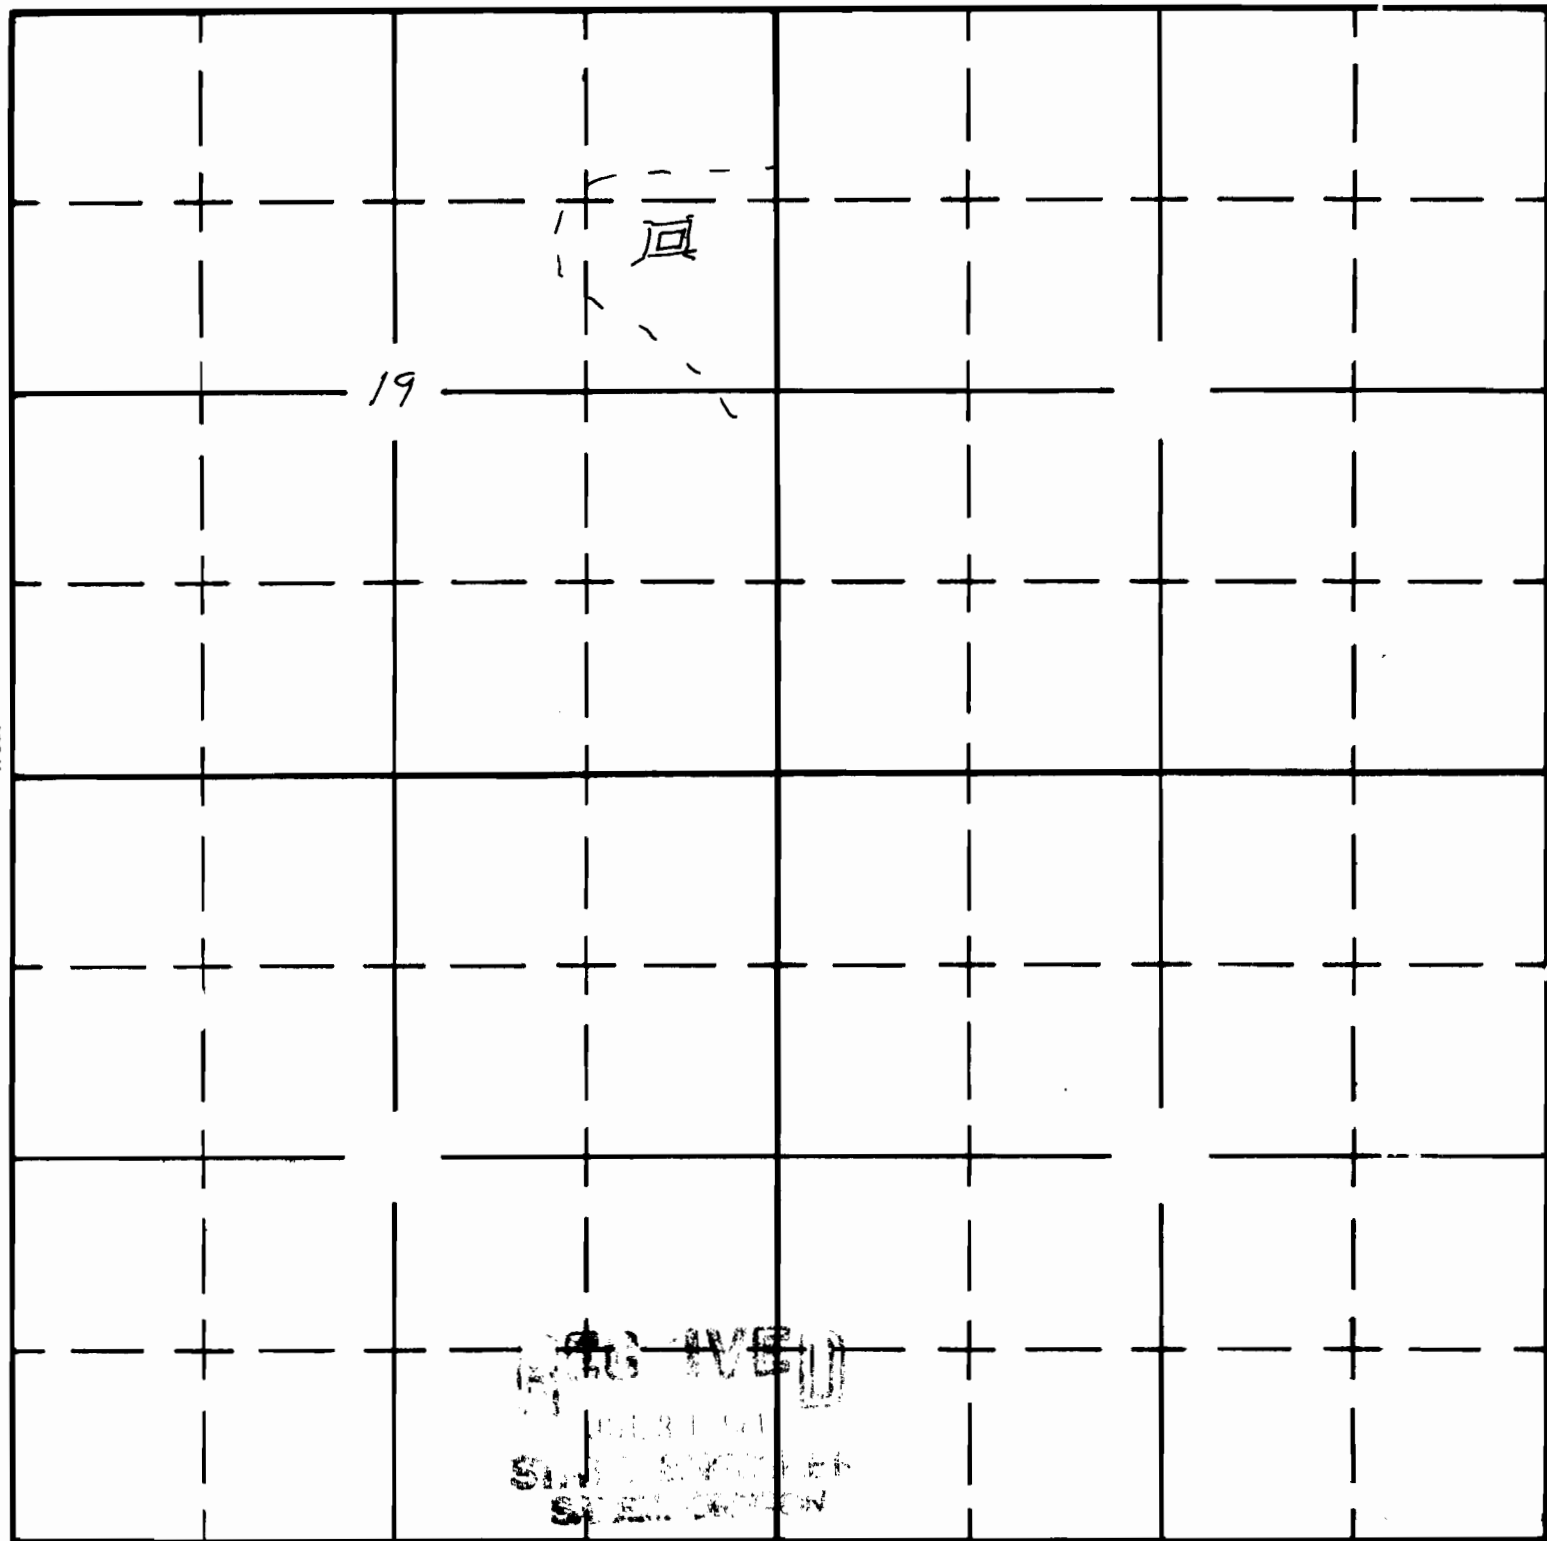

South

APPLICATION No. R-35839

PERMIT No. R-3496