

Form A1-187
March 1961

UNITED STATES
DEPARTMENT OF THE INTERIOR
BUREAU OF LAND MANAGEMENT

SECTION


NW¹ SE¹

SEC. 22

Oregon State Water Filings

TOWNSHIP 26 S, RANGE 25 E, W. M.

North

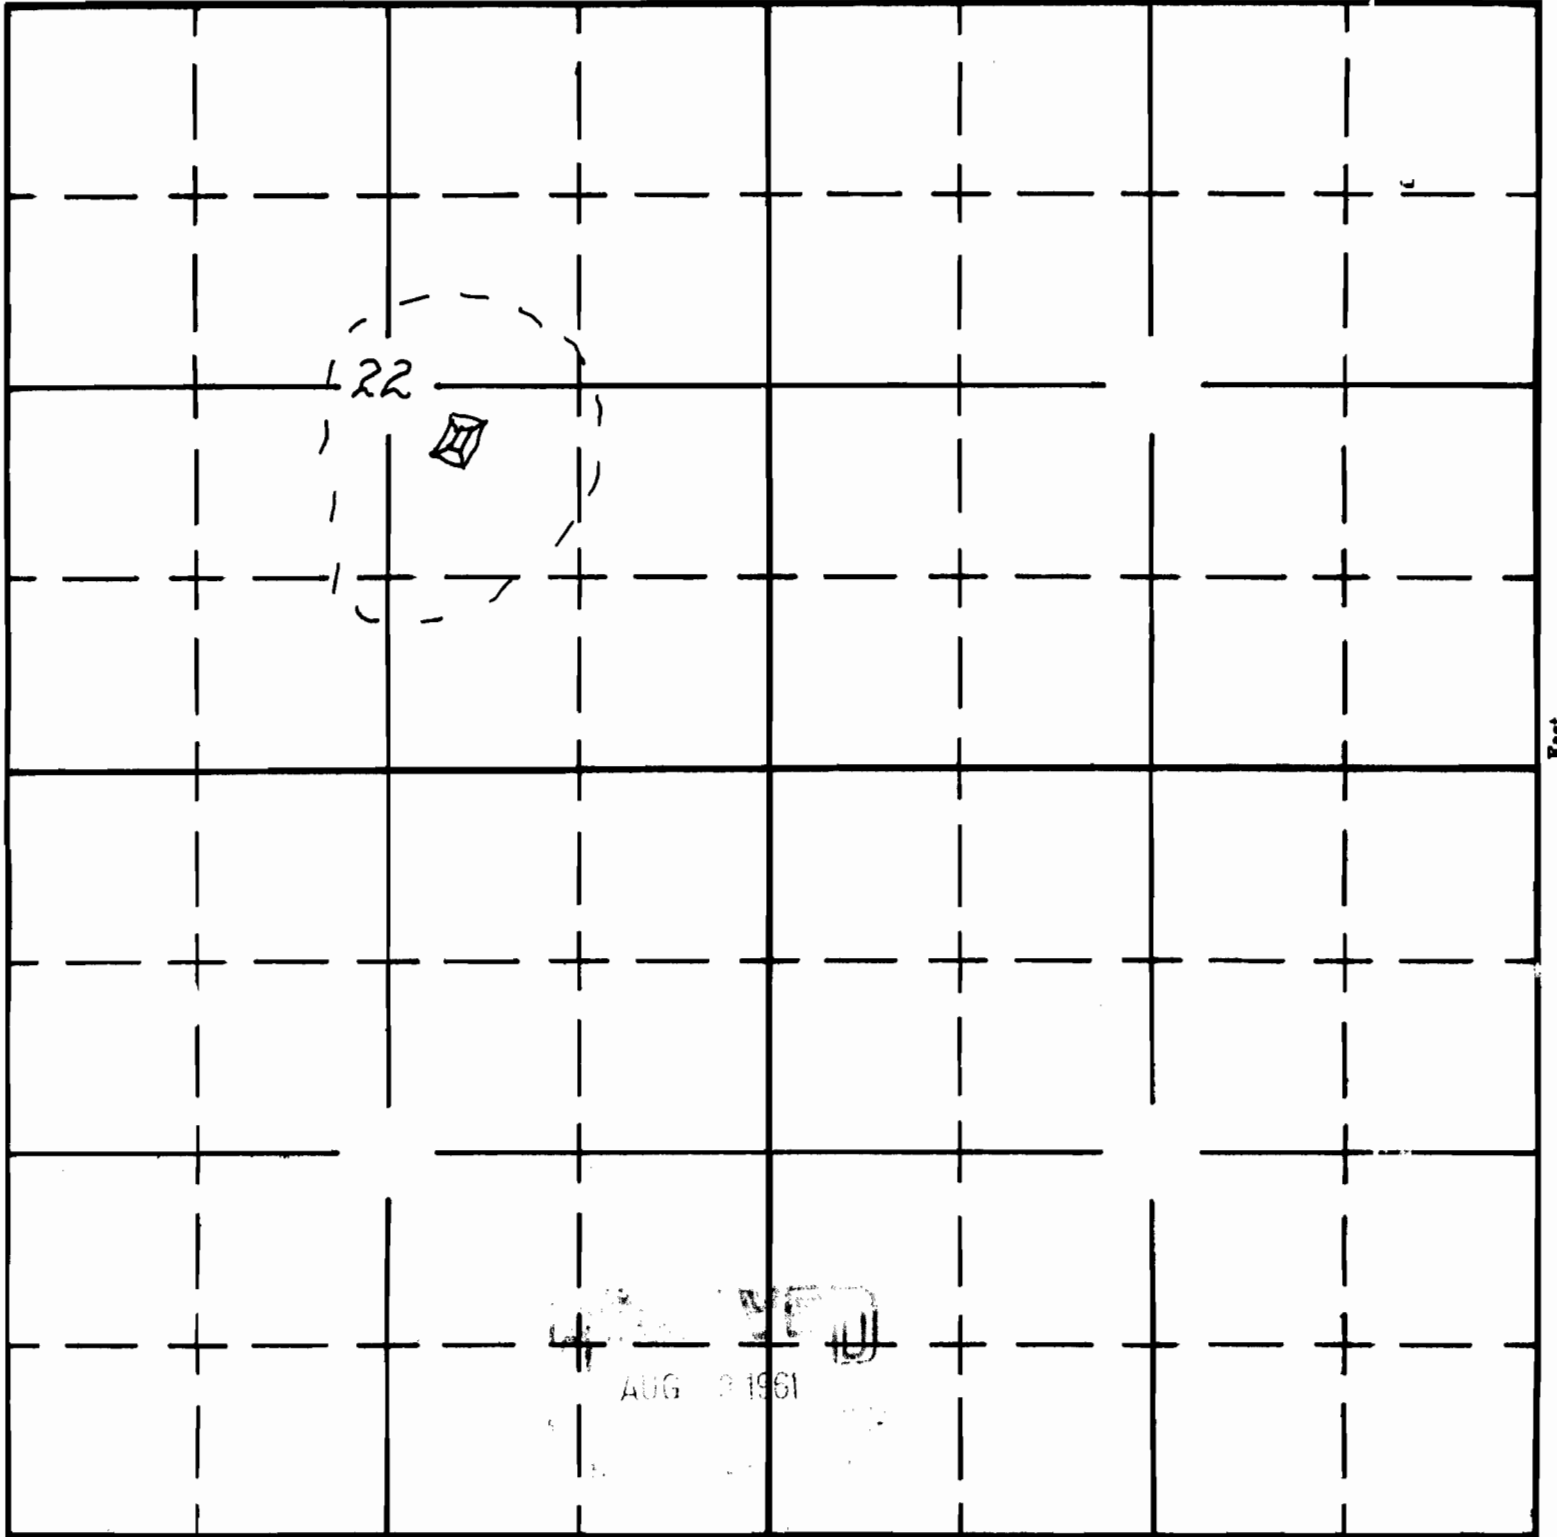

South

APPLICATION No. R-36094
PERMIT No. R-3560