

UNITED STATES
DEPARTMENT OF THE INTERIOR
BUREAU OF LAND MANAGEMENT

SECTION


NE 1/4 SE 1/4

Oregon State Water Filings

13

TOWNSHIP 22 S., RANGE 32 E., W. M.

North

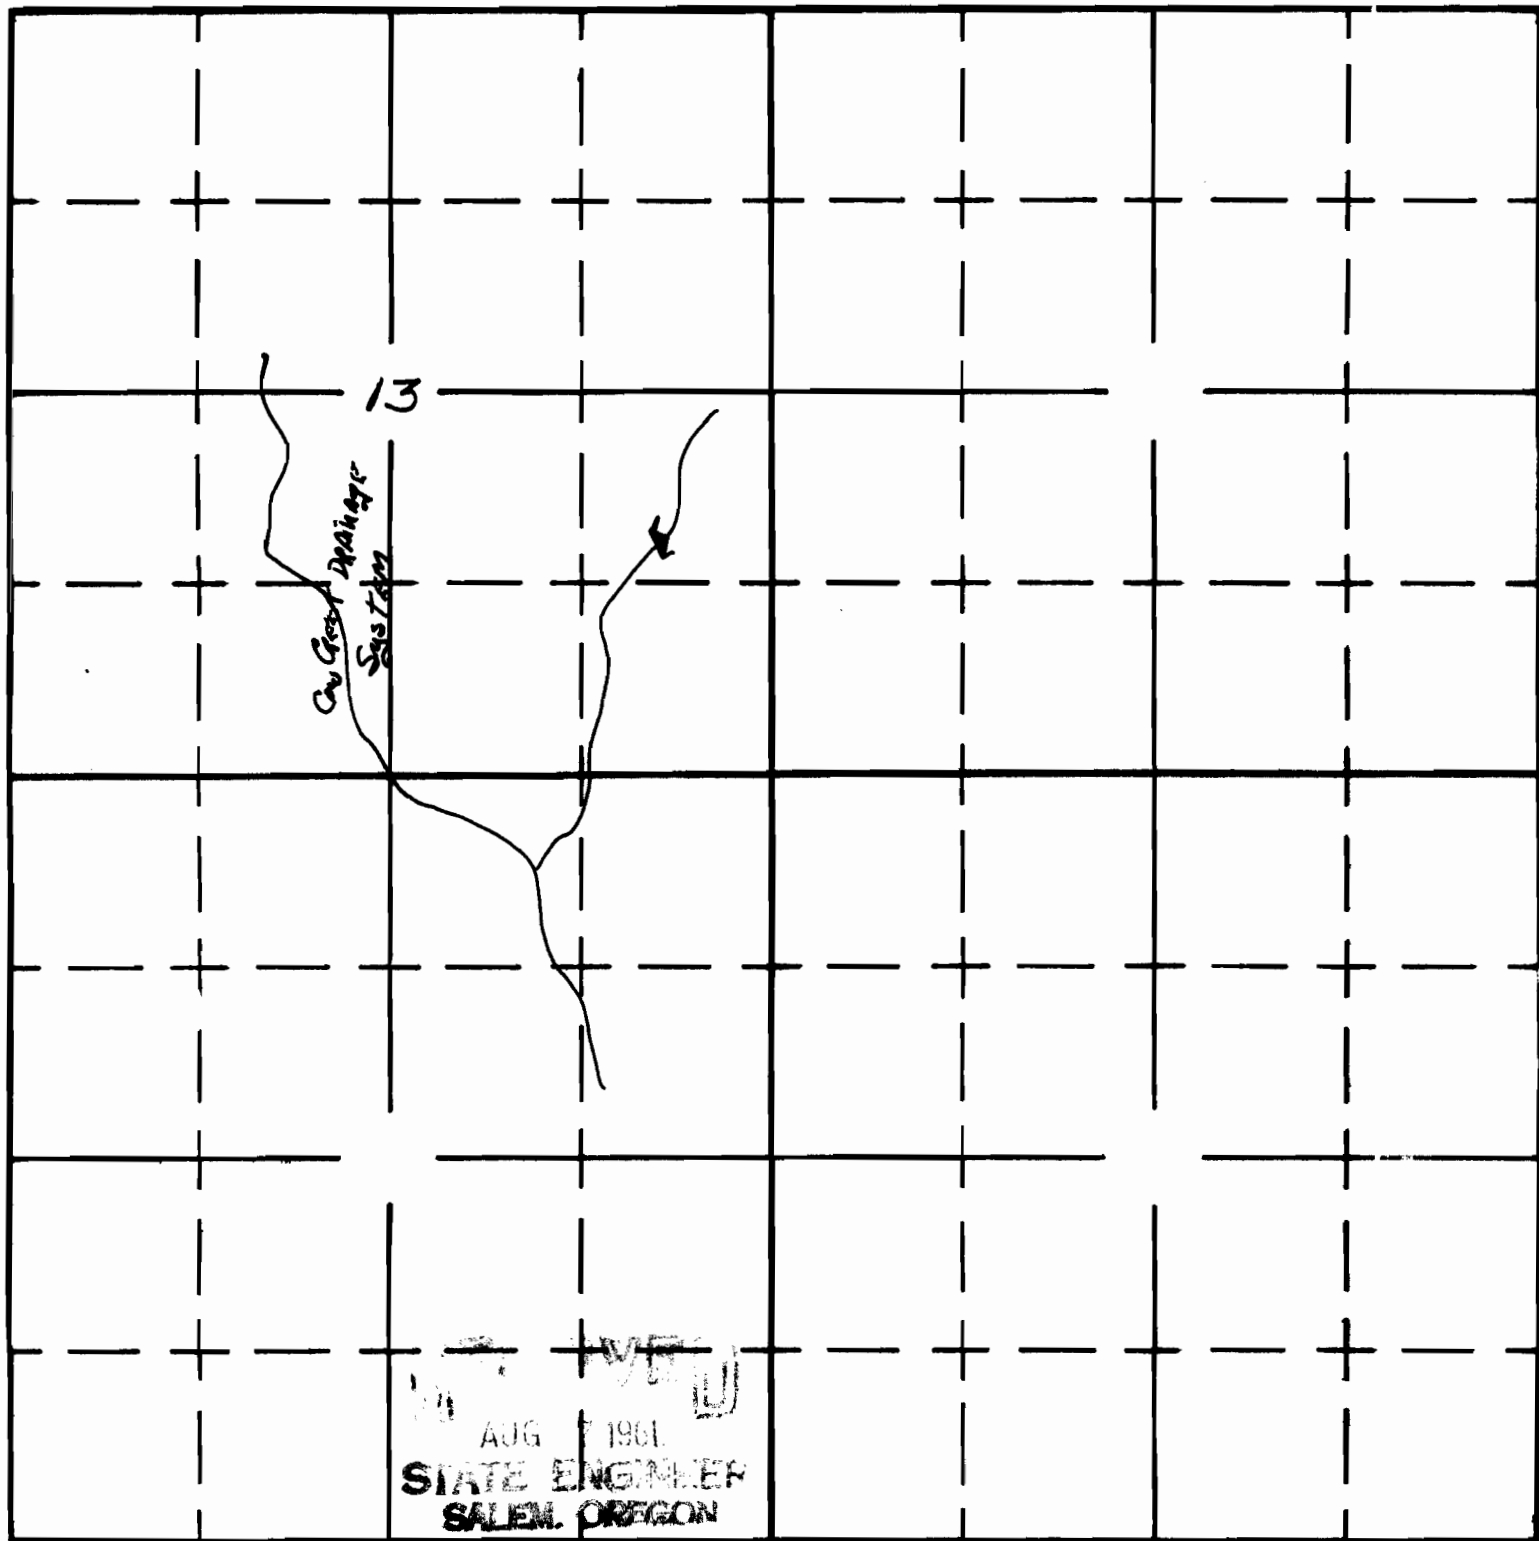

APPLICATION No. R-36118
PERMIT No. R-3566